

November 4, 2020

Garrisons Lake Boat Ramp Reconstruction
DFW Contract No. NAT20001-Garrisons

Addendum 2: Question Responses and Drawing Revisions

1. Section 6/C105 shows what appears to be vinyl D bumper on wood fenders mounted to each side of the sidewalk. Is this required on the sidewalk since it is above OHW elevation and one side is buried in riprap?
 - a. RESPONSE: Bumper is to be placed on sidewalk to provide protection from trailers and vehicles.
2. Section 6/C105 shows 4" x 4" curbs at each edge of the sidewalk. The plan view on the same plan page shows aluminum handrail on the riprap side. Please clarify if you want the curb or handrail on the riprap side of the sidewalk.
 - a. RESPONSE: Handrails are to be placed on rip-rap side. Handrail will be included in the GatorDock equipment/material provided by Division of Fish and Wildlife.
3. The plan view on C105 shows proposed grade lines beyond the LOD. Clearing and fill placement will be required to achieve these proposed grades. Do you want the grading as shown? If so, you will need to adjust the LOD and associated CFL placement.
 - a. RESPONSE: Revised Construction Displays provided:
 - i. Sheet C103; Revision 2; Adjusted Compost Filter Log and Limit of Disturbance; 11-03-2020
 - ii. Sheet C104; Revision 1; Provided New Detail 5/C104; 11-03-2020
 - iii. Sheet C104; Revision 1; Provided New Detail 5/C104; 11-03-2020
4. Section 5/104 shows riprap to be placed from proposed grade down to the OHW elevation. Do you want riprap placed down to the OHW elevation for all of the proposed riprap surface area shown? If so, riprap will be over 6' thick in places.
 - a. RESPONSE: Revised Construction Displays provided:
 - i. Sheet C103; Revision 2; Adjusted Compost Filter Log and Limit of Disturbance; 11-03-2020

- ii. Sheet C104; Revision 1; Provided New Detail 5/C104; 11-03-2020
- iii. Sheet C104; Revision 1; Provided New Detail 5/C104; 11-03-2020

John Sclesky, P.E.

Century Engineering

CONSTRUCTION PLANS

FOR

DELAWARE DIVISION OF FISH & WILDLIFE

GARRISON'S LAKE BOAT RAMP RECONSTRUCTION

T.P. #: LC-00-037.03-03-58.00

US 13, NORTH DUPONT HIGHWAY & MESSINA HILL ROAD

LITTLE CREEK HUNDRED, KENT COUNTY, DELAWARE


DFW CONTRACT #: NAT20001-GARRISONS



SOIL MAP NOT TO SCALE

SOIL LEGEND	
DocB =	DOWNER SANDY LOAM, 2 TO 5 PERCENT SLOPES, MID-ATLANTIC COASTAL PLAIN
Zo =	ZEKIAH SANDY LOAM, FREQUENTLY FLOODED
W=	WATER

INDEX OF SHEETS	
C100	COVERSHEET
C101	LEGEND, PROJECT NOTES & TYPICAL SECTIONS
C102	EXISTING CONDITIONS & DEMOLITION PLAN
C103	CONSTRUCTION LAYOUT PLAN
C104	FIXED DOCK DETAILS SHEET
C105	BOAT RAMP DETAILS SHEET
C106	CONSTRUCTION DETAILS
C107-C110	EROSION & SEDIMENT CONTROL DETAILS

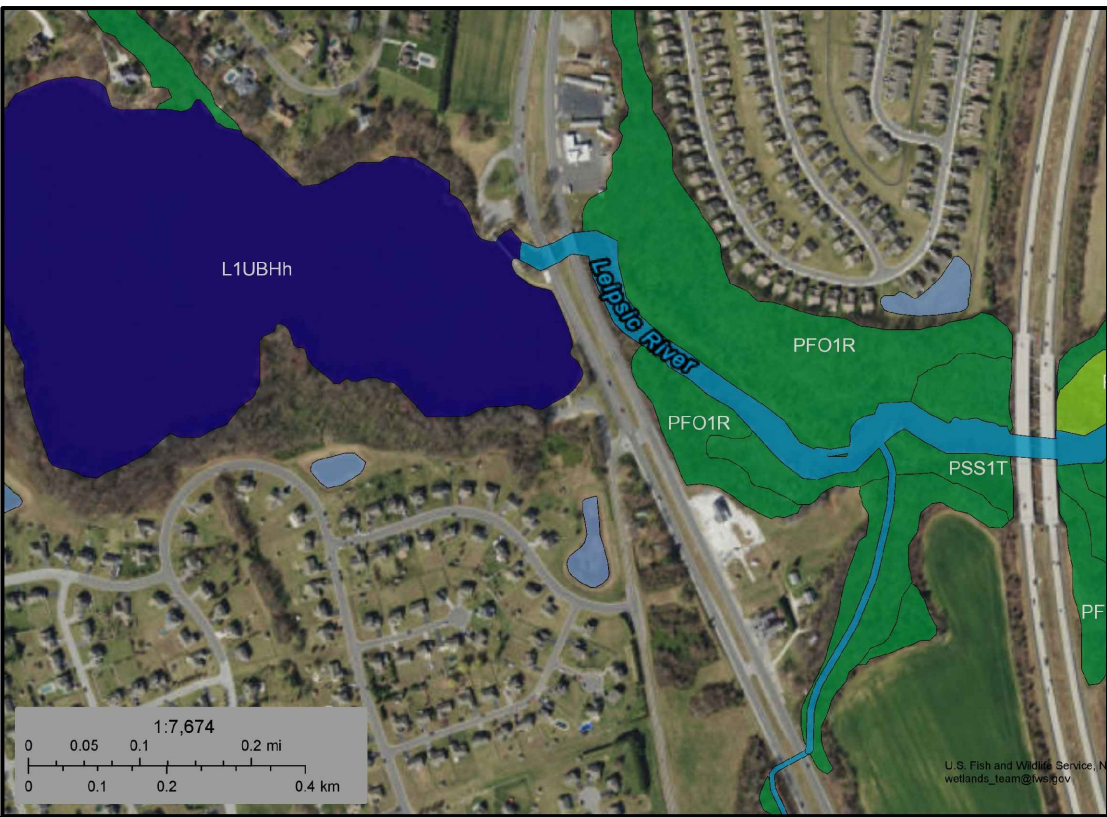

WETLAND MAP NOT TO SCALE

WETLAND LEGEND	
L1UBHh	= LACUSTRINE SYSTEM, LIMNETIC SUBSYSTEM, WITH UNCONSOLIDATED BOTTOM, PERMANENTLY FLOODED DUE TO DOWNSTREAM IMPOUNDMENT.
PF01R	= PALUSTRINE SYSTEM, WITH 6' OR TALLER FORESTED WOODY VEGETATION, WITH BROAD-LEAVED DECIDUOUS, AND SEASONALLY FLOODED-TIDAL.
PS5IT	= PALUSTRINE SYSTEM, WITH 6' OR SHORTER WOODY VEGETATION, WITH BROAD-LEAVED DECIDUOUS, AND SEMIPERMANENTLY FLOODED-TIDAL.

WETLANDS PERMITTING

A PERMIT NUMBER, CENAP-OP-2020-230-85 (NWP36), FROM THE UNITED STATES ARMY CORPS OF ENGINEERS WAS OBTAINED TO PERMIT THE DISTURBANCES TO EXISTING FEDERALLY REGULATED WATERS OF THE UNITED STATES. A SUBAQUEOUS LANDS PERMIT FROM THE DNR WETLANDS AND SUBAQUEOUS LANDS SECTION WILL BE SOUGHT FOR IMPACTS TO THE EXISTING STATE SUBAQUEOUS LANDS.

DATA COLUMN		
1.	TAX PARCEL NUMBER:	LC-00-037.03-03-58.00
2.	KENT COUNTY FILE NUMBER:	
3.	ADDRESS OF SITE:	927 MESSINA HILL ROAD, DOVER DE, 19001
4.	ZONING:	AC: AGRICULTURAL CONSERVATION
5.	SOURCE OF TITLE:	D.B. 58-79
6.	NUMBER OF LOTS:	1
7.	SETBACK LINES:	
	FRONT YARD:	75'
	SIDE YARD:	25' (60' TOTAL)
	REAR YARD:	40'
	MIN LOT WIDTH:	150'
8.	LOT AREA:	40.30+ ACRES (BASED ON KENT COUNTY GIS MAPPING)
9.	EXISTING USE:	BOAT RAMP/PARKING LOT
10.	PROPOSED USE:	BOAT RAMP/PARKING LOT
11.	TOTAL NUMBER OF LOTS	1 (NO NEW BUILDING LOTS OR DWELLINGS PROPOSED BY THIS PLAN)
12.	PROPOSED BUILDING SQUARE FOOTAGE:	0 S.F.
13.	MONUMENTS:	
	EXISTING:	0 (MONUMENT)
	PROPOSED:	0 (MONUMENT)
14.	ELECTRIC PROVIDER:	NO ELECTRIC PROPOSED FOR SITE
15.	SEWER PROVIDER:	NO SEWER PROPOSED FOR SITE
16.	WATER PROVIDER:	NO ON-SITE WELL OR WATER SOURCE PROPOSED FOR SITE
17.	PARKING:	
	REQUIRED:	N/A
	PROPOSED:	15 SPACES
18.	SITE BREAKDOWN (WITHIN PROJECT LOC):	
	EXISTING SPACE:	9,504.41 ± S.F.
	OPEN SPACE:	2,097.38 ± S.F.
	WATER:	2,097.38 ± S.F.
	ASPHALT:	7,684.34 ± S.F.
	CONCRETE:	1,830.64 ± S.F.
	OVERALL TOTAL:	20,886.77 ± S.F.
	PROPOSED SITE:	
	OPEN SPACE:	8,979.70 ± S.F.
	WATER:	2,097.38 ± S.F.
	ASPHALT:	7,956.92 ± S.F.
	CONCRETE:	1,852.77 ± S.F.
	OVERALL TOTAL:	20,886.77 ± S.F.
18.	WETLANDS:	A WETLANDS INVESTIGATION HAS BEEN PERFORMED ON THE SUBJECT PROPERTY BY CENTURY ENGINEERING, INC. IN OCTOBER, 2019.
19.	FLOODPLAIN:	PER FEMA MAP NO.10001C0152J, DATED JULY 7, 2014, THE SUBJECT PARCEL IS DETERMINED TO BE WITHIN ZONE AE (BASE FLOOD ELEVATION DETERMINED: ELEV.: 11).
20.	GROWTH ZONE:	THE SUBJECT PARCEL LIES WITHIN THE DESIGNATED GROWTH ZONE.
21.	BOUNDARY:	NO BOUNDARY SURVEY HAS BEEN COMPLETED.
22.	TOPOGRAPHY:	TOPOGRAPHY SHOWN FROM A SURVEY PERFORMED BY CENTURY ENGINEERING, INC. IN OCTOBER, 2019.
23.	DATUM:	NAD83
24.	TOTAL LOD OF SITE:	19,026.69 S.F. (NO SEDIMENT & STORMWATER MANAGEMENT APPROVAL REQUIRED)
25.	SITE BENCHMARK:	TRAVERSE POINT #1 SEE SHEET C102 FOR LOCATION
26.	OWNER:	LAKESHORE VILLAGE HOMEOWNERS PO BOX 97 CHESWOLD, DE 19936 927 MESSINA HILL ROAD NOTE: PER AN EASEMENT AGREEMENT BETWEEN GOLDINGER BROTHERS INCORPORATED AND THE STATE OF DELAWARE DATED AUGUST 28, 1983, THE DIVISION OF FISH & WILDLIFE HAS CONFIRMED PERMISSION TO ERECT, MAINTAIN, AND OPERATE FACILITIES.
27.	APPLICANT:	STATE OF DELAWARE DIVISION OF FISH & WILDLIFE 89 KINGS HIGHWAY DOVER, DE 19001 JEREMY ASHE (302) 735-3601
28.	ENGINEER:	CENTURY ENGINEERING, INC. 550 BAY ROAD DOVER, DE 19001 ALEXANDER SCHMIDT, P.E. (302) 734-9188

CERTIFICATION OF OWNER

I, JEREMY ASHE, HEREBY CERTIFY THAT DIVISION OF FISH & WILDLIFE IS THE OWNER OF THE PROPERTY DESCRIBED AND SHOWN ON THIS PLAN, THAT THE PLAN WAS MADE AT MY DIRECTION, AND THAT I ACKNOWLEDGE THE SAME TO ME BY ACT AND DESIRE THE PLAN TO BE DEVELOPED AS SHOWN IN ACCORDANCE WITH ALL APPLICABLE LAWS AND REGULATIONS.

JEREMY ASHE - CONSTRUCTION MANAGER DELAWARE DIVISION OF FISH & WILDLIFE 89 KINGS HIGHWAY DOVER, DE 19901 PHONE: (302) 735-3601	DATE
--	------

CERTIFICATION OF APPLICANT

I, JEREMY ASHE, HEREBY CERTIFY THAT DELAWARE DIVISION OF FISH & WILDLIFE IS THE APPLICANT OF THE PROPERTY DESCRIBED AND SHOWN ON THIS PLAN, THAT THE PLAN WAS MADE AT MY DIRECTION, AND THAT I ACKNOWLEDGE THE SAME TO ME BY ACT AND DESIRE THE PLAN TO BE DEVELOPED AS SHOWN IN ACCORDANCE WITH ALL APPLICABLE LAWS AND REGULATIONS.

JEREMY ASHE - CONSTRUCTION MANAGER
DELAWARE DIVISION OF FISH & WILDLIFE
89 KINGS HIGHWAY
DOVER, DE 19901
PHONE: (302) 735-3601

CERTIFICATION OF PLAN ACCURACY

I, ALEXANDER SCHMIDT, HEREBY CERTIFY THAT THIS PLAN HAS BEEN PREPARED UNDER MY SUPERVISION AND TO THE BEST OF MY KNOWLEDGE COMPLIES WITH THE APPLICABLE STATE AND LOCAL REGULATIONS AND ORDINANCES.

ALEXANDER E. SCHMIDT, P.E., DE NO. 16139
CENTURY ENGINEERING, INC.
550 BAY ROAD
DOVER, DELAWARE 19901
PHONE: (302) 734-9188 / FAX: (302) 734-4589

This drawing is the property of Century Engineering, Inc. and is prepared for the exclusive use of its clients at the location indicated. No other use is authorized or intended.

CENTURY
ENGINEERING, INC.

ADDRESS:
550 BAY ROAD
DOVER, DE 19901
P: (302) 734-9188 F: (302) 734-4589
WEBSITE:
www.centuryeng.com
EMAIL:
ce@centuryeng.com

REVISIONS

ADDENDUM

 DESCRIPTION	DATE
---	------

PROJECT

CONSTRUCTION PLANS
FOR
DELAWARE DIVISION OF FISH & WILDLIFE
GARRISON'S LAKE BOAT RAMP RECONSTRUCTION
LITTLE CREEK HUNDRED, KENT COUNTY, DELAWARE

COVERSHEET

DIV. OF FISH AND WILDLIFE BID SET

DRAWN	CHK'D/DESIGNER
-------	----------------

	ECM	AES
1	0.0000	0.0000
2	0.0000	0.0000
3	0.0000	0.0000
SCALE	SHEET NO.
-------	-----------


AS NOTED 0.000

PROJECT NO. C100


C:\Projects\175013.00 (DNREC 2017 Engineering OE)\175013.43 (Garrisons Lake Boat Ramp)\CADD FILES\Sheets\Construction Plans\C100_CoverSheet.dwg, 11/3/2020 2:26 PM

LEGEND		
EXISTING		PROPOSED
PROPERTY LINE	_____	N/A
RIGHT OF WAY	_____ RW _____ RW	N/A
BUILDING SETBACK	_____	N/A
CONTOUR	_____	N/A
WETLAND LINE	_____ VV _____	N/A
ORDINARY HIGH WATER MARK	_____ OHW _____ OHW	N/A
SIGN	_____	N/A
UTILITY POLE	_____	N/A
PAVEMENT	_____	_____
OVERLAY PAVEMENT	N/A	_____
REMOVABLE BOLLARD	N/A	•
CONCRETE AREA	_____	_____
FIXED DOCK	N/A	_____
RIP RAP	_____	_____
DE #3 STONE	N/A	_____
TIMBER SUPPORT PILE	N/A	•
TEMPORARY SHEET PILE	N/A	_____
LIMITS OF CONSTRUCTION	N/A	_____ LOC _____ LOC
LIMITS OF DISTURBANCE	N/A	_____ LOD _____ LOD
GUY WIRE	_____	N/A
TOP OF BANK	_____ TOB _____ TOB	N/A
BOTTOM OF BANK	_____ BOB _____ BOB	N/A
SAWCUT	N/A	_____ SAW _____ SAW
100-YR FLOOD PLAIN	_____ FP _____	N/A
STEEL BEAM GUARDRAIL	_____	N/A
UNDERGROUND GAS	_____ UG-G _____ UG-G	N/A
UNDERGROUND TELEPHONE	_____ UG-T _____ UG-T	N/A
OVERHEAD ELECTRIC	_____ OH-E _____ OH-E	N/A
SILT FENCE	N/A	_____ SF _____ SF
STOCKPILE AREA	N/A	_____ SP _____ SP
PORTABLE SEDIMENT TANK	N/A	_____ PST _____
PUMPING PIT	N/A	_____ PP-2 _____
COMPOST FILTER LOG	N/A	_____ CFL _____ CFL
GAS VALVE	N/A	N/A
P.C.C. CURB	N/A	_____

IDENTIFIERS	
RM	REMOVE BY CONTRACTOR
C	

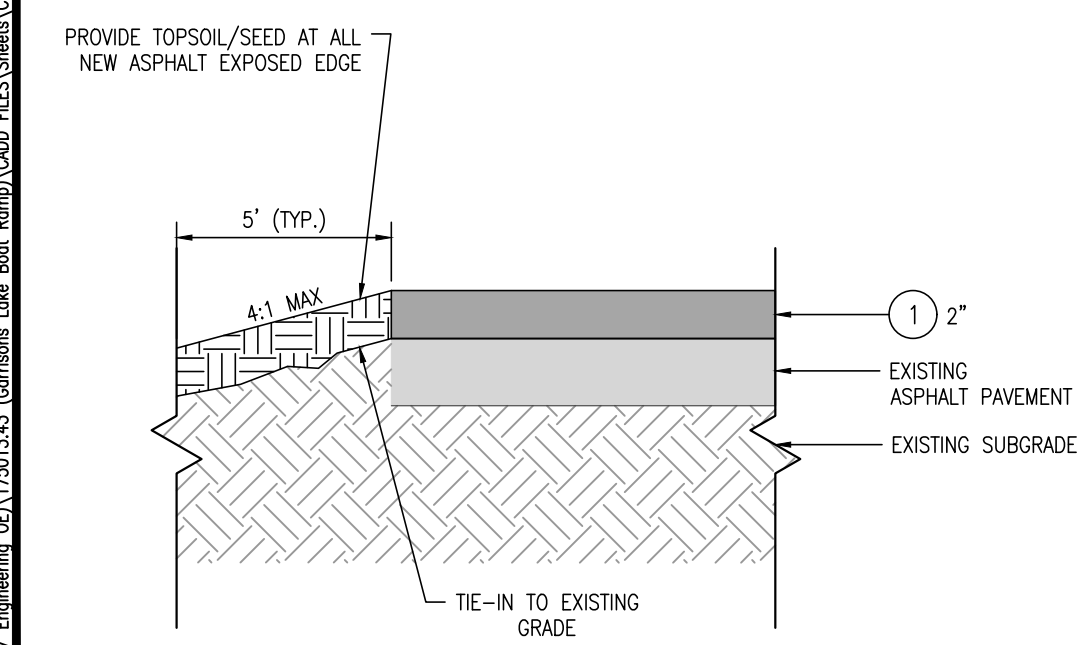

1 TYPICAL SECTION - OVERLAY PAVEMENT
NOT TO SCALE

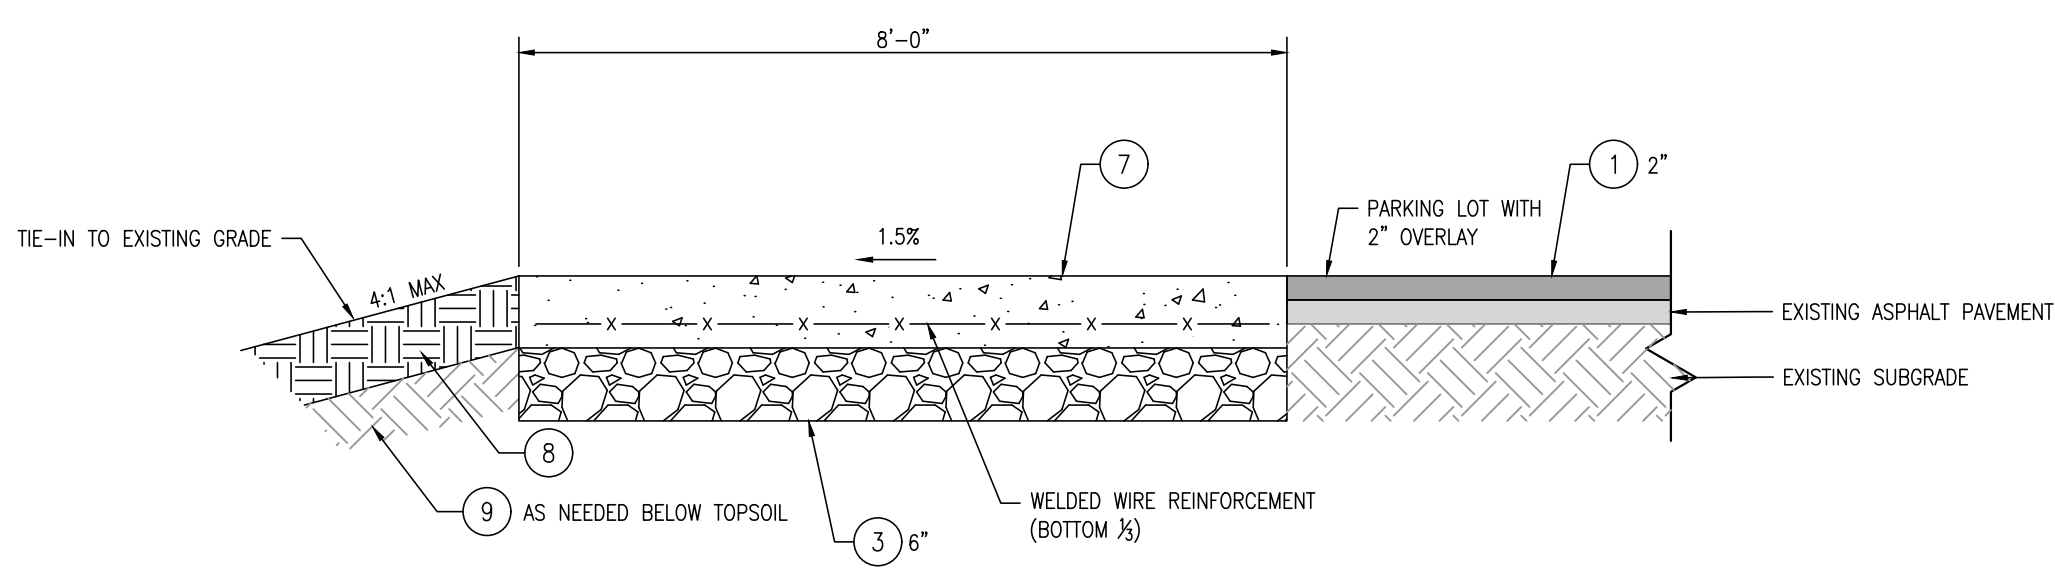

2 TYPICAL SECTION - PORTABLE RESTROOM PAD
NOT TO SCALE

DESIGN AND CONSTRUCTION SPECIFICATIONS:

- LOADS:
 - LIVE LOAD – FIXED DOCKS: 40 POUNDS PER SQUARE FOOT WITH A MAXIMUM DEFLECTION OF L/180.
- MATERIALS:
 - ALUMINUM:
 - ALL STRUCTURAL ALUMINUM IS ALLOY 6061-T6, MILL FINISH.
 - ALL WELDED FABRICATION IN ACCORDANCE WITH AWS D1.2, UNLESS NOTED OTHERWISE. FILLER METAL TO BE 5356 SERIES WIRE.
 - REINFORCING STEEL:
 - ALL REINFORCING STEEL SHALL BE AASHTO M31, (ASTM A615), GRADE 60.
 - ALL REINFORCING STEEL SHALL BE EPOXY COATED IN ACCORDANCE WITH AASHTO M284.
 - TIMBER:
 - PILES SHALL BE CLASS B SOUTHERN YELLOW PINE IN ACCORDANCE WITH ASTM D25.
 - DIMENSION LUMBER SHALL BE SOUTHERN YELLOW PINE, NO. 2 OR BETTER.
 - ALL PILES AND DIMENSION LUMBER SHALL BE TREATED WITH CHROMATED COPPER ARSENATE (CCA) WITH A MINIMUM RETENTION OF 2.5 POUNDS PER CUBIC FOOT.
 - CONCRETE:
 - ALL EXPOSED CONCRETE PAD EDGES SHALL HAVE A 1" CHAMFER.
 - AN OPTIONAL TRANSVERSE CONSTRUCTION JOINT MAY BE PLACED AT THE MID-SPAN OF THE BOAT RAMP AS SHOWN.
 - ALL CONCRETE WORK SHALL BE IN ACCORDANCE WITH SECTION 610 OF THE DELDOT STANDARD SPECIFICATIONS FOR ROAD AND BRIDGE CONSTRUCTION (DATED AUGUST 2016) UNLESS OTHERWISE NOTED.
 - SUBMIT CONCRETE MIX DESIGNS FOR REVIEW AND APPROVAL PRIOR TO STARTING WORK. ALL CONCRETE SHALL USE A DELDOT APPROVED MIX.
 - CONCRETE DESIGN MIXES/STRENGTHS SHALL HAVE A MINIMUM COMPRESSIVE STRENGTH OF F'c = 4,500 PSI. ALL CONCRETE SHALL CONTAIN A WATER-REDUCING ADMIXTURE. CALCIUM CHLORIDE IS PROHIBITED.
 - CONCRETE FOR RAMP SHALL BE DELDOT CLASS A (F'c = 4,500 PSI) AND SHALL CONFORM TO SECTION 610004 – PORTLAND CEMENT MASONRY, ABUTMENT ABOVE FOOTING, CLASS A.
 - UNLESS OTHERWISE SHOWN, CONCRETE COVER OVER REINFORCEMENT SHALL BE 1" FOR INTERIOR FACE OF WALLS NOT EXPOSED TO EARTH, 2" FOR EXTERIOR FACE OF WALLS, 3" FOR FOOTINGS AND OTHER STRUCTURAL CONCRETE DEPOSITED AGAINST GROUND, 2" FOR CONCRETE PERMANENTLY EXPOSED TO EARTH OR WEATHER, AND 0.75" FOR SLABS.
 - NO CONCRETE SHALL BE PLACED IN WATER OR ON FROZEN SUBGRADE.
 - THE REQUIRED AIR CONTENT FOR ALL CONCRETE SHALL BETWEEN 3% AND 7%.
 - PROOF ROLL SUBGRADES FOR PAVED AREAS UNDER THE DIRECTION OF THE INSPECTION AGENCY. REMOVE ALL UNSUITABLE AREAS AND REPLACE WITH COMPACTED STRUCTURAL FILL MATERIALS. PLACE FILL IN 6" LIFTS AND COMPACT FILL TO AT LEAST 90% OF THE MAXIMUM DENSITY AS DETERMINED BY THE ASTM D1557 MODIFIED PROCTOR TEST. FILL MATERIAL SHALL BE SM OR BETTER AS CLASSIFIED PER ASTM D2487.
 - CONCRETE SHALL BE POURED WITHIN 24 HOURS OF EXCAVATION UNLESS APPROVED BY THE ENGINEER.
 - CONNECTIONS:
 - ALL BOLTS AND NAILS SHALL BE HOT-DIPPED GALVANIZED IN ACCORDANCE WITH ASTM A153, AASHTO M232 OR STAINLESS STEEL IN ACCORDANCE WITH ASTM A316, AS SHOWN ON THE PLANS.
 - BOLTED CONNECTIONS THAT ARE EXPOSED TO PEDESTRIANS SHALL BE POSITIONED SUCH THAT THE BOLT HEADS FACE THE DECK AND NUTS FACE AWAY FROM THE PUBLIC.
 - CONTRACTOR SHALL PROVIDE DEWATERING SYSTEM AS NECESSARY FOR CONSTRUCTION OF BOAT RAMP AND FIXED DOCK. CONTRACTOR SHALL OBTAIN ANY NECESSARY DEWATERING PERMITS. DEWATERING SYSTEM SHALL BE INCIDENTAL TO THE CONTRACT.
 - ALL DOCK HARDWARE IS TO BE STAINLESS STEEL, SERIES 304.
 - ALL DOCKS, HEADER CHANNELS, RAILING, AND ANCILLARY ITEMS SHALL BE PROVIDED BY THE OWNER.
 - THE NOTES ON THESE DRAWINGS ARE NOT INTENDED TO REPLACE SPECIFICATIONS. SEE SPECIFICATIONS FOR REQUIREMENTS IN ADDITION TO GENERAL NOTES. FOR INCONSISTENCIES BETWEEN THESE DRAWINGS AND THE SPECIFICATIONS, THE STRICTER REQUIREMENT SHALL APPLY, AND THE ENGINEER SHALL BE NOTIFIED PRIOR TO PROCEEDING WITH THE AFFECTED PORTION OF THE WORK.
 - THE STRUCTURE IS DESIGNED TO BE SELF SUPPORTING AND STABLE AFTER THE CONSTRUCTION IS COMPLETE. IT IS THE CONTRACTOR'S SOLE RESPONSIBILITY TO DETERMINE ERECTION PROCEDURES AND SEQUENCE TO ENSURE THE SAFETY OF THE STRUCTURE AND ITS COMPONENTS DURING ERECTION. THIS INCLUDES, BUT IS NOT LIMITED TO, THE ADDITION OF NECESSARY SHORING, SHEETING, TEMPORARY BRACING, GUYS OR TIE DOWNS. PROVIDE ALL SHORING AND BRACING REQUIRED TO STABILIZE AND PROTECT EXISTING AND ADJACENT STRUCTURES AND SYSTEMS DURING COURSE OF DEMOLITION AND CONSTRUCTION. SUCH MATERIAL SHALL REMAIN THE PROPERTY OF THE CONTRACTOR AFTER COMPLETION OF THE PROJECT.
 - SECTIONS AND DETAILS SHOWN ON ANY STRUCTURAL DRAWINGS SHALL BE CONSIDERED TYPICAL FOR SIMILAR CONDITIONS.
 - ALL APPLICABLE FEDERAL, STATE AND MUNICIPAL REGULATIONS SHALL BE FOLLOWED, INCLUDING THE FEDERAL DEPARTMENT OF LABOR OCCUPATIONAL SAFETY AND HEALTH ACT.
 - ANY AND ALL MODIFICATIONS TO THE STRUCTURAL ELEMENTS INDICATED ON THESE DRAWINGS MUST BE APPROVED IN ADVANCE BY THE ENGINEER.

PILE INSTALLATION NOTES

- FULL TIME INSPECTION OF THE PILE INSTALLATION SHALL BE PROVIDED BY OWNER AND PERFORMED BY AN ENGINEER OR EXPERIENCED FOUNDATION INSPECTOR REGISTERED AS A PROFESSIONAL ENGINEER IN THE STATE OF DELAWARE TO ESTABLISH AN ACCURATE RECORD OF PILE DRIVING. INSPECTION SHOULD VERIFY THAT SUITABLE PILES ARE BEING INSTALLED. RECORDS SHALL INCLUDE PROJECT NAME AND NUMBER, NAME OF CONTRACTOR, PILE LOCATION AND NUMBER, COMPILED PILE CAPACITY, TYPE AND SIZE OF HAMMER USED, TYPE OF PILE DRIVING CAP USED, RATE OF OPERATION OF PILE DRIVING EQUIPMENT, PILE DIMENSIONS, ELEVATION OF TIP, ELEVATION OF BUTT BEFORE AND AFTER CUT-OFF, GROUND ELEVATION, CONTINUOUS RECORD OF NUMBER OF BLOWS FOR EACH FOOT OF PENETRATION, PLUMBNESS, HORIZONTAL LOCATION, PILE UPLIFT AND ANY UNUSUAL OCCURRENCES DURING PILE DRIVING.
- ALL TIMBER SUPPORT PILES SHALL BE DRIVEN IN THE LOCATIONS SHOWN ON THE PLANS WITHIN THE FOLLOWING TOLERANCES. DEVIATION OF THE LOCATION OF THE TOP OF A PILE FROM THAT SHOWN ON PLANS SHALL NOT EXCEED 2 INCHES AFTER INITIAL DRIVING, AND 4 INCHES AFTER DRIVING IS COMPLETED. PILES SHALL BE DRIVEN WITH A MAXIMUM DEVIATION FROM VERTICAL OF 1 INCH IN 48 INCHES OF PILE LENGTH.

SECTION/DETAIL/MATERIALS

- SUPERPAVE TYPE C, PG 64-22, (ITEM NO. 401005)
- SUPERPAVE TYPE B, PG 64-22, (ITEM NO. 401014)
- GRADED AGGREGATE BASE COURSE, TYPE B, (ITEM NO. 301001)
- BORROW, TYPE B, MAXIMUM 8" LIFTS, COMPACTION: 95% OF MAXIMUM DENSITY PER MODIFIED PROCTOR TEST (ITEM NO. 209008)
- GEOTEXTILE, SEPARATION (ITEM NO. 708002)
- 4" PCC SIDEWALK (ITEM NO. 705001)
- 6" PCC SIDEWALK (ITEM NO. 705002)
- 6" TOPSOIL, SEED, MULCH
- BORROW TYPE F (ITEM NO. 209006)

NOTE: ALL ITEM NUMBERS REFERENCE DELDOT STANDARD SPECIFICATIONS/ITEMS.


HIERARCHY OF CONTRACT DOCUMENTS

ELEMENTS UNDER THIS CONTRACT SHALL BE CONSTRUCTED UTILIZING THE FOLLOWING INFORMATION IN THE HIERARCHY LISTED BELOW:


- CONTRACT AGREEMENT BETWEEN OWNER AND CONTRACTOR.
- APPROVED PLANS.
- PROJECT MANUAL AND ENCLOSED TECHNICAL SPECIFICATIONS.
- STATE OF DELAWARE DEPARTMENT OF NATURAL RESOURCES AND ENVIRONMENTAL CONTROL EROSION AND SEDIMENT CONTROL HANDBOOK, FEBRUARY, 2019 OR MOST CURRENT AT DATE OF ADVERTISEMENT.
- DELAWARE DEPARTMENT OF TRANSPORTATION STANDARD CONSTRUCTION DETAILS, 2018, OR MOST CURRENT AT ADVERTISEMENT.
- DELAWARE DEPARTMENT OF TRANSPORTATION STANDARDS AND SPECIFICATIONS FOR BRIDGE AND ROAD CONSTRUCTION, 2016, OR MOST CURRENT AT DATE OF ADVERTISEMENT.

GENERAL NOTES


- THE CONTRACTOR SHALL NOTIFY DNREC FISHERIES DIVISION AT (302) 735-8654 SEVEN (7) DAYS PRIOR TO ANY CONSTRUCTION SO THAT FISHERIES CAN PREPARE APPROPRIATE PRESS RELEASES.
- THERE SHALL BE NO IN WATER WORK COMPLETED APRIL 1 – JULY 30.
- IT SHALL BE THE RESPONSIBILITY OF THE CONTRACTOR TO PLACE A MINIMUM OF TWO SIGNS INFORMING THE PUBLIC OF UPCOMING CONSTRUCTION ACTIVITIES AND AREA CLOSURE. THE SIGNS SHALL BE A MINIMUM OF 8.5"x11" LAMINATED PAPER AND SHALL SAY "NOTICE TO THE PUBLIC: THIS AREA WILL BE CLOSED FROM (INSERT DATE) TO (INSERT DATE) DUE TO CONSTRUCTION ACTIVITIES. PLEASE CALL THE DIVISION OF FISH & WILDLIFE FISHERIES SECTION AT 302-739-9914 WITH ANY QUESTIONS." SIGNS SHALL BE POSTED A MINIMUM OF TWO WEEKS BEFORE THE CONSTRUCTION CLOSURE. SIGN LOCATIONS SHALL BE COORDINATED WITH THE FISHERIES PROJECT MANAGER.
- CONTRACTOR SHALL CONTACT MISS UTILITY OF DELMARVA AT 1-800-282-8555 48 HOURS PRIOR TO ANY EXCAVATION ACTIVITIES.
- CONTRACTOR SHALL COORDINATE ALL CONSTRUCTION WITH WORKING DRAWINGS PROVIDED BY THE DOCK MANUFACTURER.
- THE CONTRACTOR SHALL CONTACT THE OWNER AND THE ENGINEER AT LEAST 48 HOURS PRIOR TO SHEET PILE AND/OR SUPPORT PILE INSTALLATION AND FOR ALL MEETINGS, INCLUDING PRE-CONSTRUCTION MEETINGS, AS REQUIRED IN THE CONSTRUCTION SPECIFICATIONS.
- CONTRACTOR SHALL LOAD TEST ALL SUBGRADE SOIL PRIOR TO THE PLACEMENT OF THE SUBBASE COURSE. ALL UNSUITABLE MATERIAL FOUND SHALL BE EXCAVATED TO THE DEPTH OF STABLE SOIL AND BACKFILLED WITH APPROVED MATERIAL. THE CONTRACTOR SHALL COMPACT ALL MATERIALS TO MEET THE DELDOT STANDARD SPECIFICATIONS.
- MAXIMUM ALGEBRAIC DIFFERENCE OF CROSS SLOPES SHALL NOT EXCEED 8%.
- BORROW, TYPE B, SHALL BE UTILIZED FOR ALL UNDERCUT LOCATIONS AS DIRECTED BY ENGINEER IN THE FIELD.
- IMPACTS TO SUBAQUEOUS LANDS HAVE BEEN PERMITTED WITHIN THE LOC LINE SHOWN. WORK BEYOND THE LOC IS STRICTLY PROHIBITED.
- THESE DRAWINGS DO NOT INCLUDE NECESSARY ELEMENTS OF CONSTRUCTION SAFETY. ALL CONSTRUCTION, INCLUDING EXCAVATION, MUST BE COMPLETED IN ACCORDANCE WITH THE RULES AND REGULATIONS OF THE OCCUPATIONAL SAFETY AND HEALTH ACT, AND ALL FEDERAL, STATE AND LOCAL REQUIREMENTS. CONTRACTOR IS SOLELY RESPONSIBLE FOR ALL SITE SAFETY.
- ORDINARY HIGH WATER MARK (OHW) ELEVATION SURVEYED BY CENTURY ENGINEERING, INC. IN OCTOBER 2019.

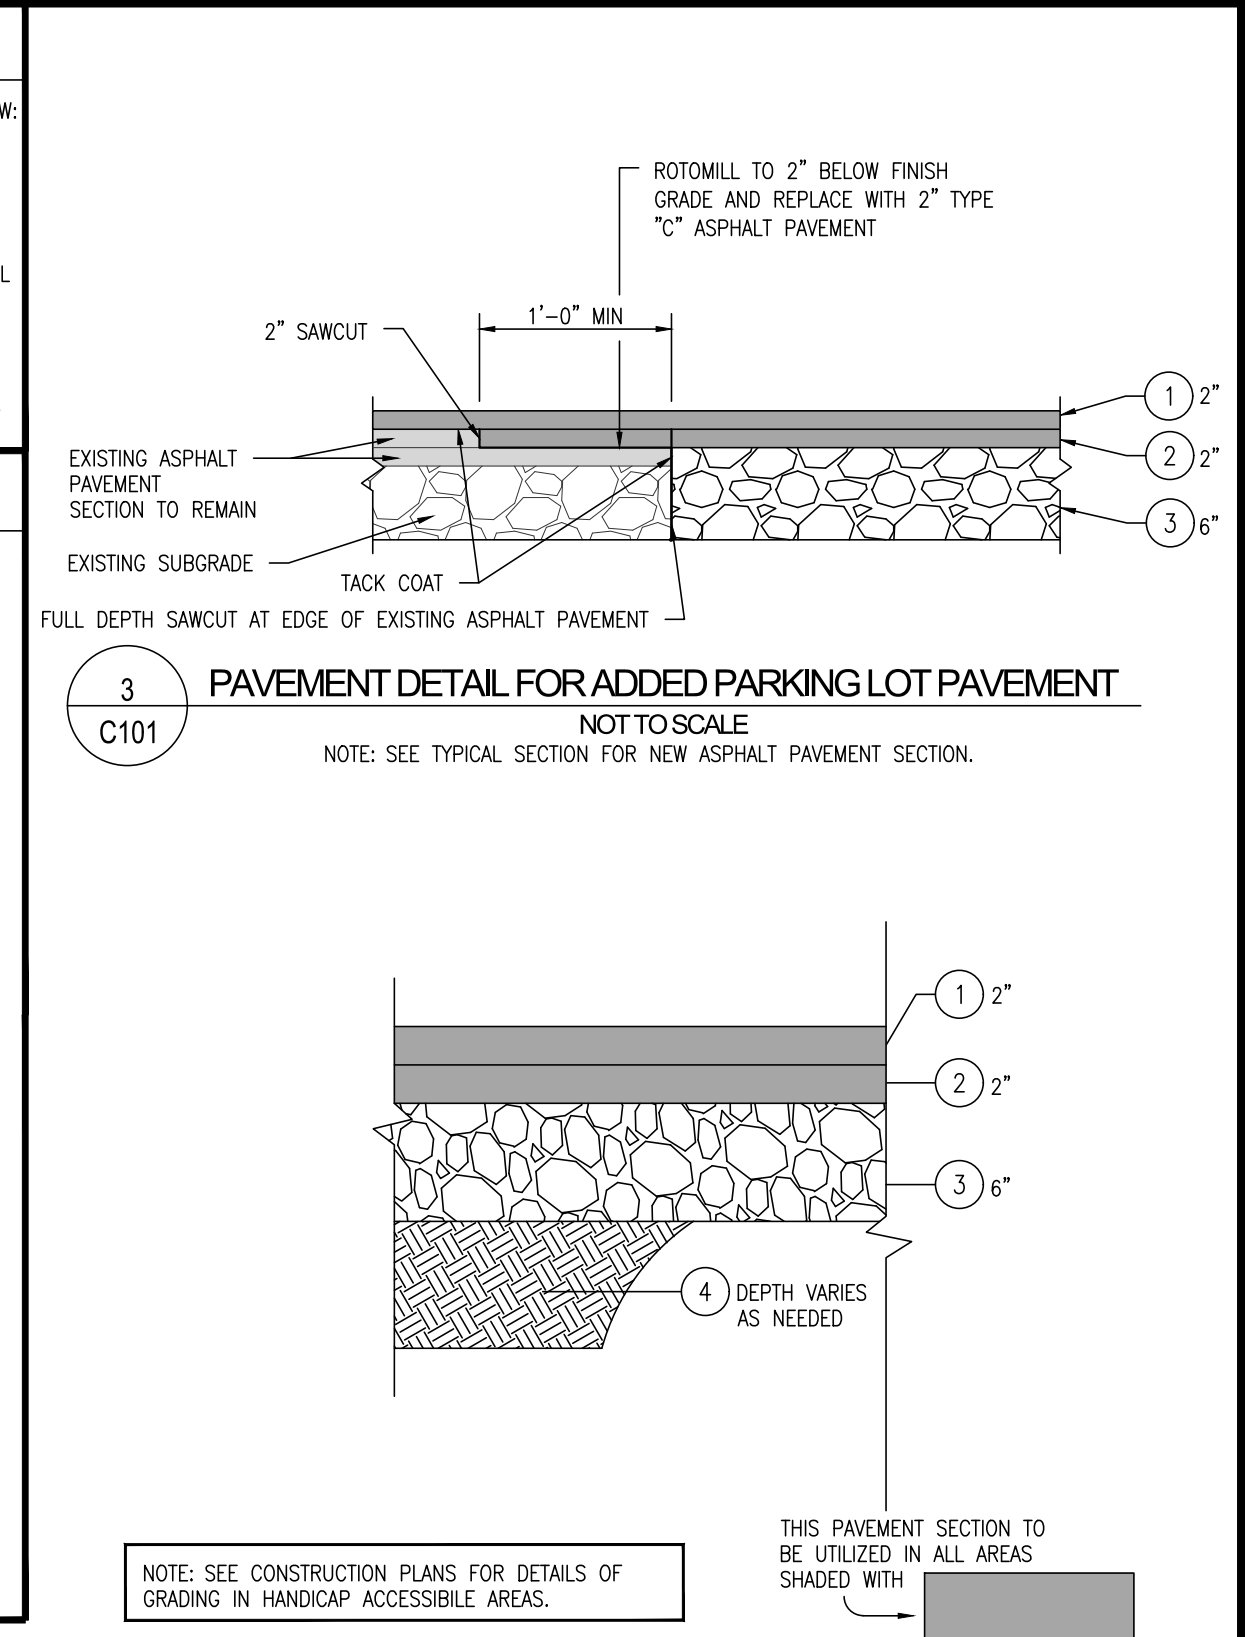


3 PAVEMENT DETAIL FOR ADDED PARKING LOT PAVEMENT
NOT TO SCALE
NOTE: SEE TYPICAL SECTION FOR NEW ASPHALT PAVEMENT SECTION.

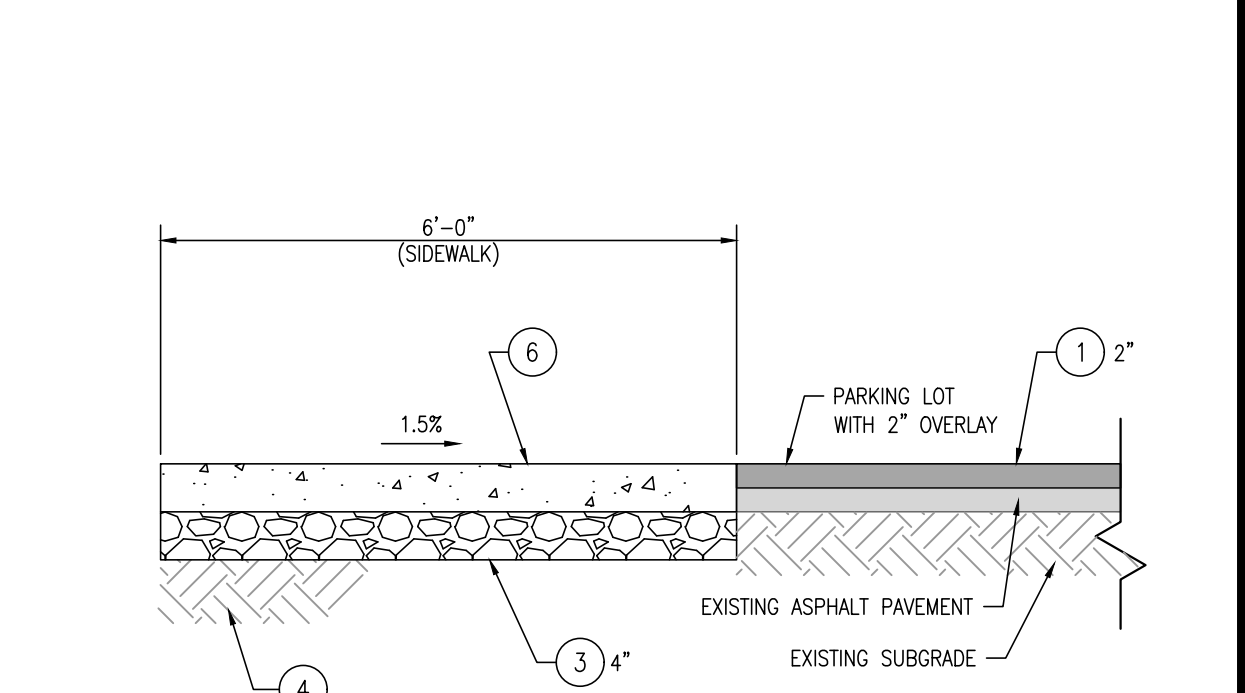

4 TYPICAL SECTION- FULL DEPTH PAVEMENT
NOT TO SCALE

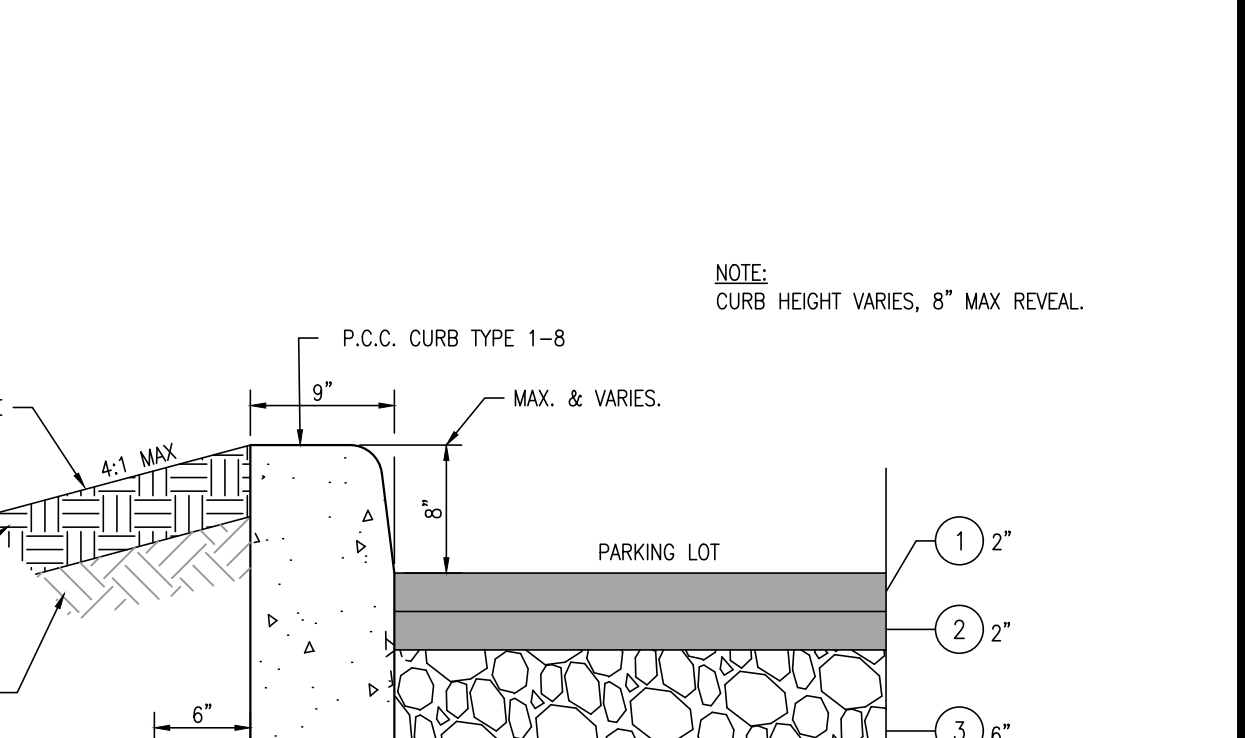

5 TYPICAL SECTION - SIDEWALK
NOT TO SCALE

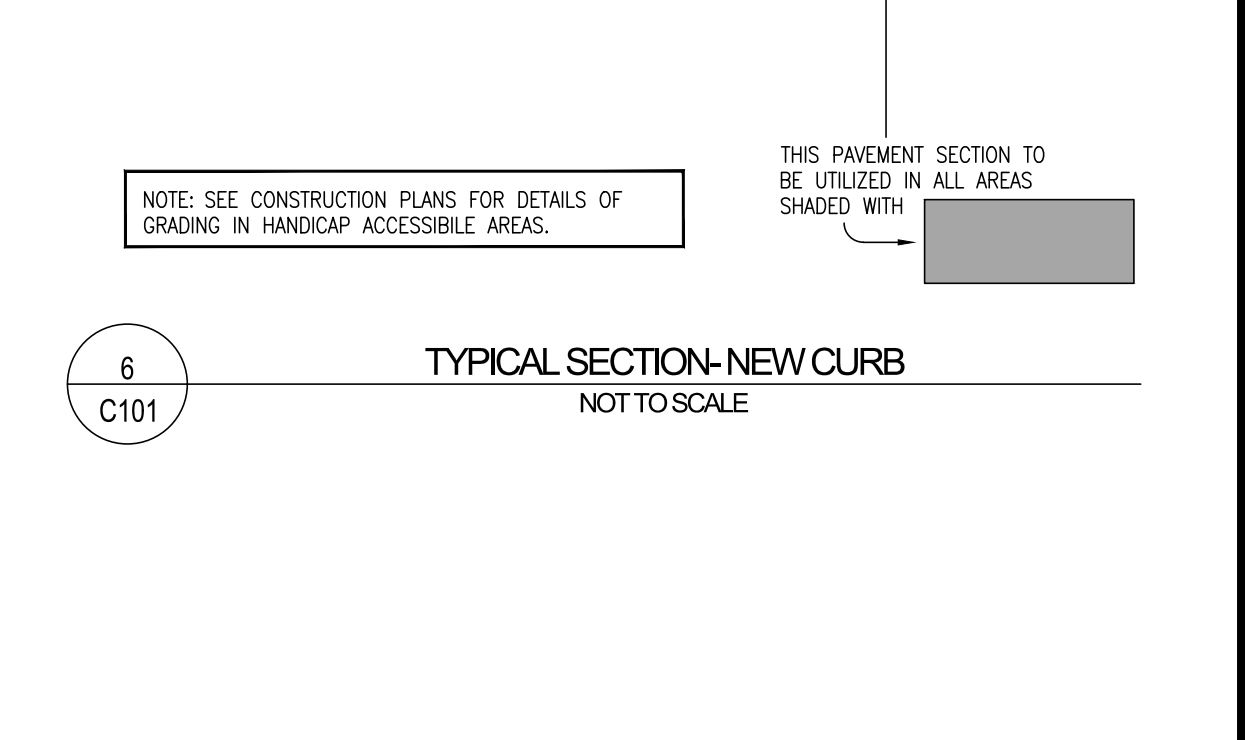

6 TYPICAL SECTION- NEW CURB
NOT TO SCALE

This drawing is the property of Century Engineering, Inc. and is prepared for the exclusive use of its clients at the location indicated. No other use is authorized or intended.

CENTURY ENGINEERING, INC.

ADDRESS: 550 BAY ROAD
DOVER, DE 19801
P: (802) 734-9188 F: (802) 734-4589

EMAIL: cei@centuryeng.com
WEBSITE: www.centuryeng.com

REVISIONS

NO.	DESCRIPTION	DATE
-----	-------------	------

ADDENDUM

NO.	DESCRIPTION	DATE
-----	-------------	------

CONSTRUCTION PLANS FOR
DELAWARE DIVISION OF FISH & WILDLIFE
GARRISON'S LAKE BOAT RAMP RECONSTRUCTION
LITTLE CREEK HUNDRED, KENT COUNTY, DELAWARE

PROJECT SHEET TITLE


LEGEND, PROJECT NOTES & TYPICAL SECTIONS

DIV. OF FISH AND WILDLIFE
BID SET
OCTOBER, 2020

DRAWN: CHK'D/DISIGNER
SCALE: SHEET NO.

ECM AES
AS NOTED
PROJECT NO. 17501343



C101

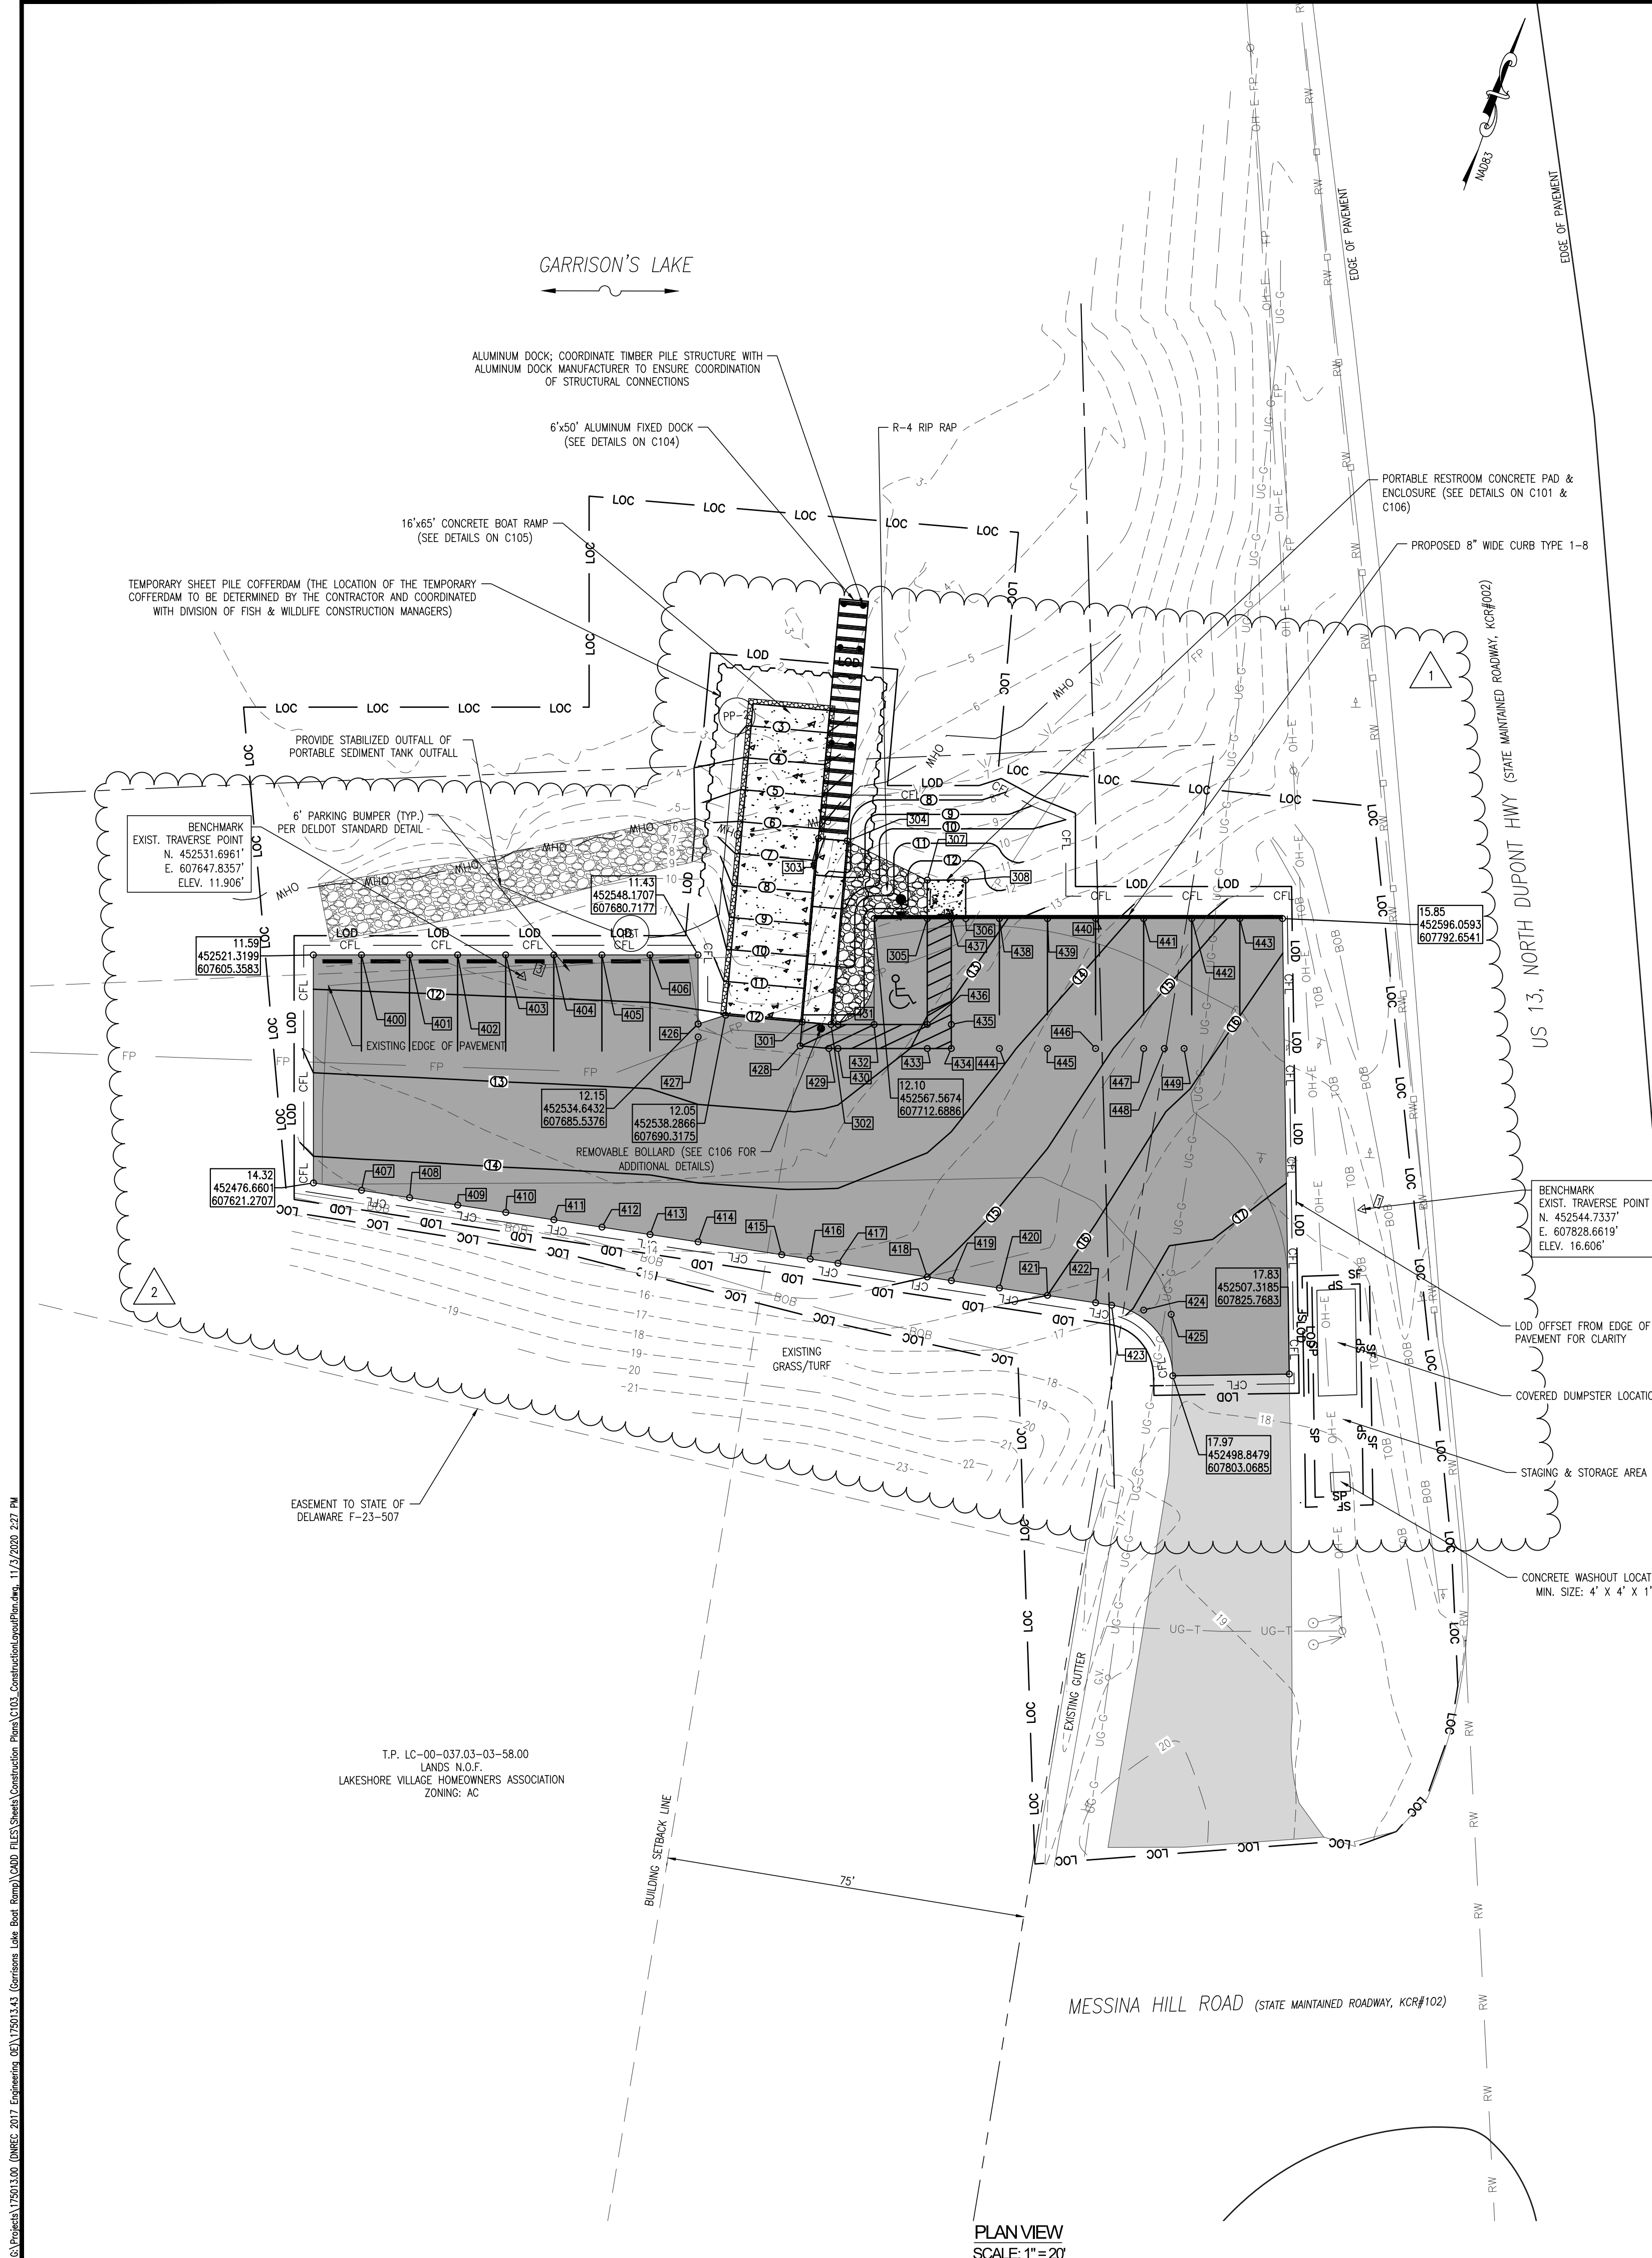

FULL DEPTH PAVEMENT LAYOUT			
POINT NO.	NORTHING	EASTING	ELEVATION
440	452583.0185	607756.0539	13.91
441	452586.3749	607765.4738	14.41
442	452589.7312	607774.8937	14.91
443	452593.0876	607784.3137	15.41
444	452550.8585	607746.2800	13.83
445	452554.2131	607755.7004	14.32
446	452557.5693	607765.1215	14.82
447	452560.9247	607774.5408	15.31
448	452562.3269	607781.9915	15.73
449	452563.7388	607782.4425	15.53

SEQUENCE OF CONSTRUCTION


1. PRIOR TO ANY CLEARING, INSTALLATION OF SEDIMENT CONTROL MEASURES, OR GRADING, A PRE-CONSTRUCTION MEETING MUST BE SCHEDULED AND CONDUCTED. THE LANDOWNER/DEVELOPER AND CONTRACTOR ARE REQUIRED TO BE IN ATTENDANCE AT THE PRE-CONSTRUCTION MEETING; THE DESIGNER IS RECOMMENDED TO ATTEND.
2. THE CONTRACTOR SHALL AT ALL TIMES PROTECT AGAINST SEDIMENT OR DEBRIS LOADED RUNOFF OR WIND FROM LEAVING THE SITE. PERIMETER CONTROLS SHOULD BE CHECKED DAILY AND ADJUSTED AND/OR REPAIRED TO FULLY CONTAIN AND CONTROL SEDIMENTATION ON THE SITE. ACCUMULATED SEDIMENT SHALL BE REMOVED WHEN IT HAS REACHED HALF OF THE EFFECTIVE CAPACITY OF THE CONTROL. IN ADDITION, THE CONTRACTOR MAY NEED TO ADJUST OR REPAIR MEASURES IN TIMES OF ADVERSE WEATHER CONDITIONS, OR AS DIRECTED BY THE OWNER'S CONSTRUCTION SITE REVIEWER.
3. INSTALL TURBIDITY CURTAIN AND/OR TEMPORARY SHEET PILE COFFERDAM. REMOVE EXISTING CONCRETE BOAT RAMP.
4. INSTALL SITE POLLUTION PREVENTION DEVICES PER DNREC STANDARD DETAILS & SPECIFICATIONS, INCLUDING CONCRETE WASHOUT.
5. INSTALL ALL TIMBER SUPPORT PILES FOR THE FIXED DOCK.
6. CLEAR AREAS AS NEEDED WITHIN LOC.
7. INSTALL SUMP PIT AND PORTABLE SEDIMENT TANK FOR DEWATERING OPERATION AT THE BOAT RAMP.
8. PERFORM ROUGH GRADING AT THE PROPOSED BOAT RAMP AND FULL DEPTH PAVEMENT AREAS.
9. PLACE STONE FOUNDATION AND CONCRETE FOR BOAT RAMP. PLACE GABC FOR AREAS OF FULL DEPTH PAVEMENT.
10. INSTALL HEADER KITS ON TIMBER PILES FOR FIXED DOCK.
11. PLACE TYPE B HOTMIX AT FULL DEPTH PAVEMENT AREAS.
12. PLACE TYPE C ASPHALT AT ALL AREAS TO BE OVERLAIN AND AT FULL DEPTH AREAS.
13. PLACE ALUMINUM FIXED DOCK AND ALL ASSOCIATED COMPONENTS.
14. STRIPE ALL PAVED AREAS.
15. STABILIZE ALL UNPAVED DISTURBED AREAS WITH MINIMUM 6" TOPSOIL, DNREC APPROVED SEED MIX, AND MULCHING.
16. EROSION & SEDIMENT CONTROL DEVICES SHALL BE REMOVED ONLY AFTER WORK IN AN AREA HAS BEEN COMPLETED AND STABILIZED, WITH WRITTEN APPROVAL FROM THE OWNER.

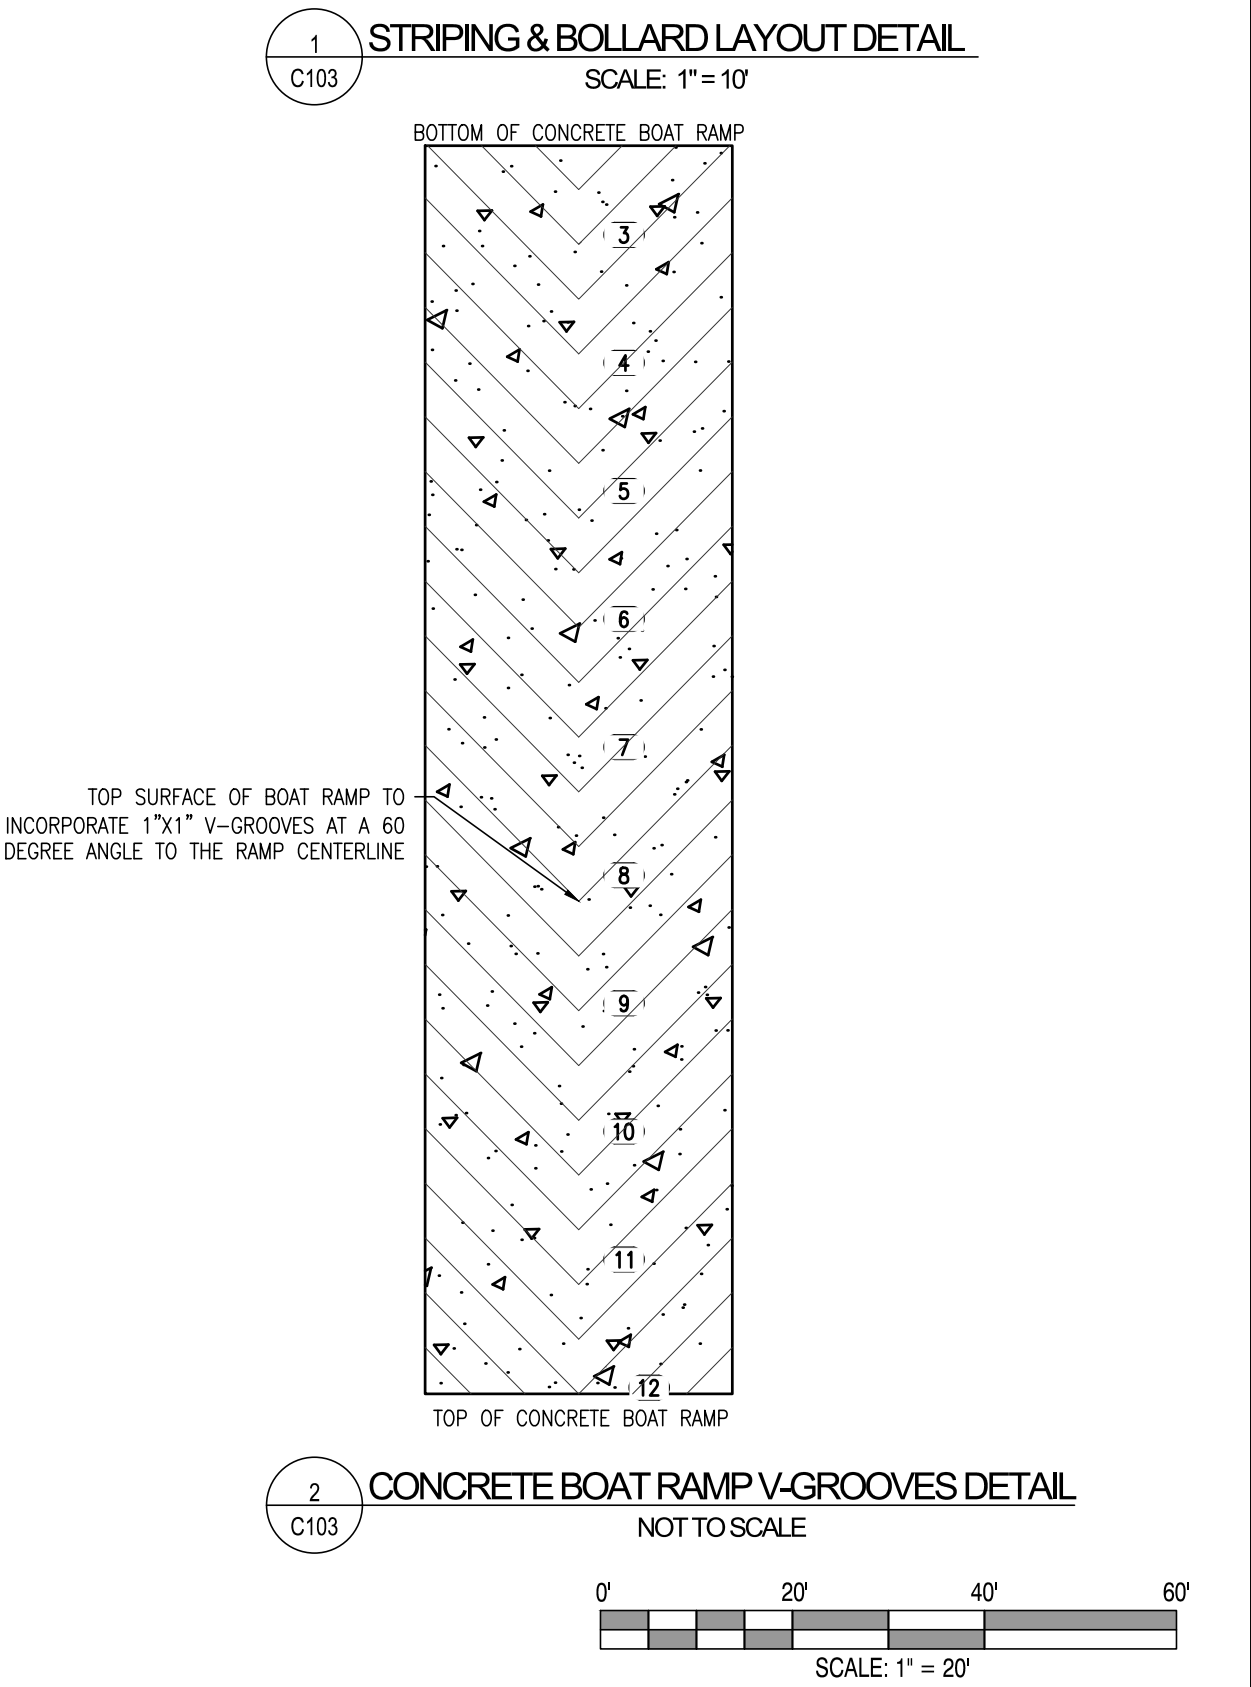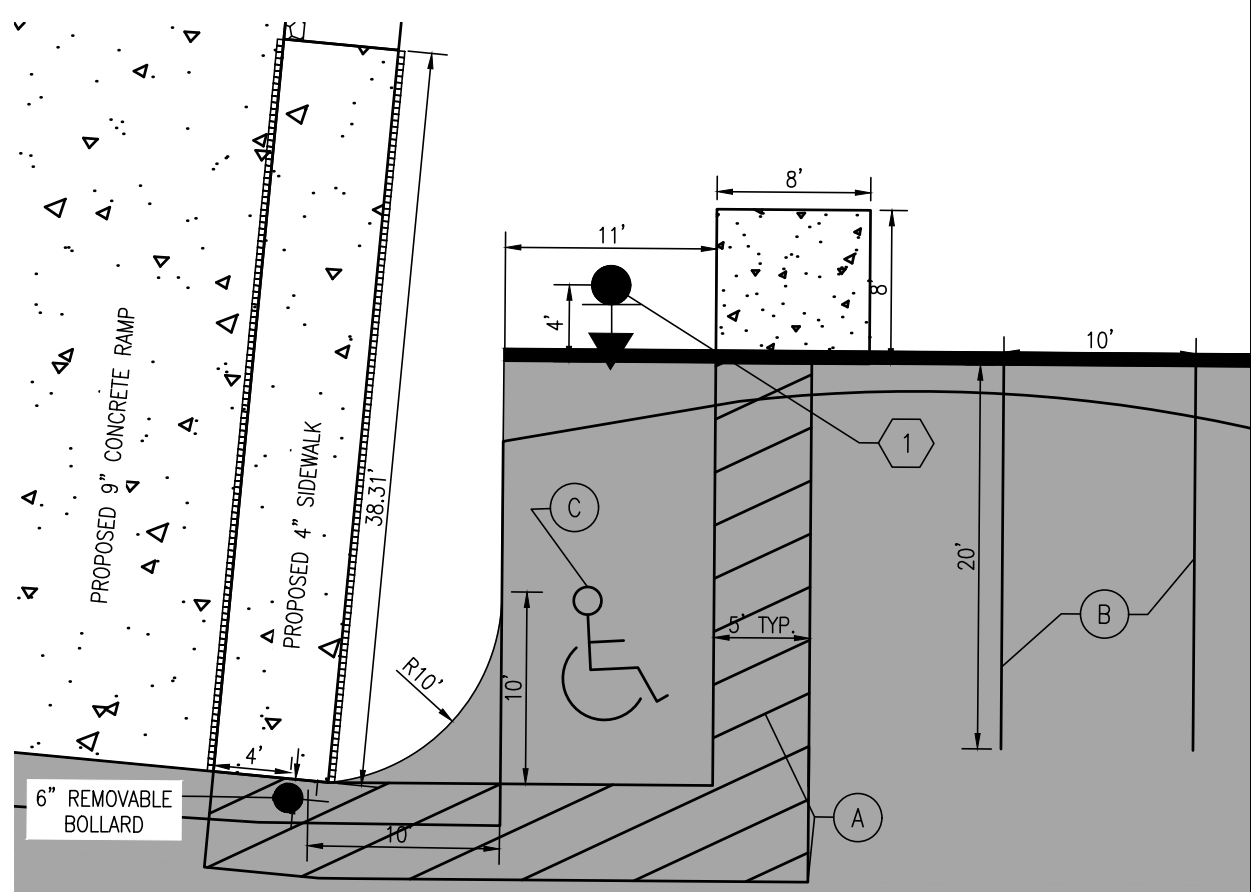


PROJECT NO.
175013.43

C103


C:\Projects\17501343_000 [DWG] 2017 Engineering [C] 17501343_000 [E] [S] [Sheet] Construction Plans [C104] 11/13/2020 2:27 PM

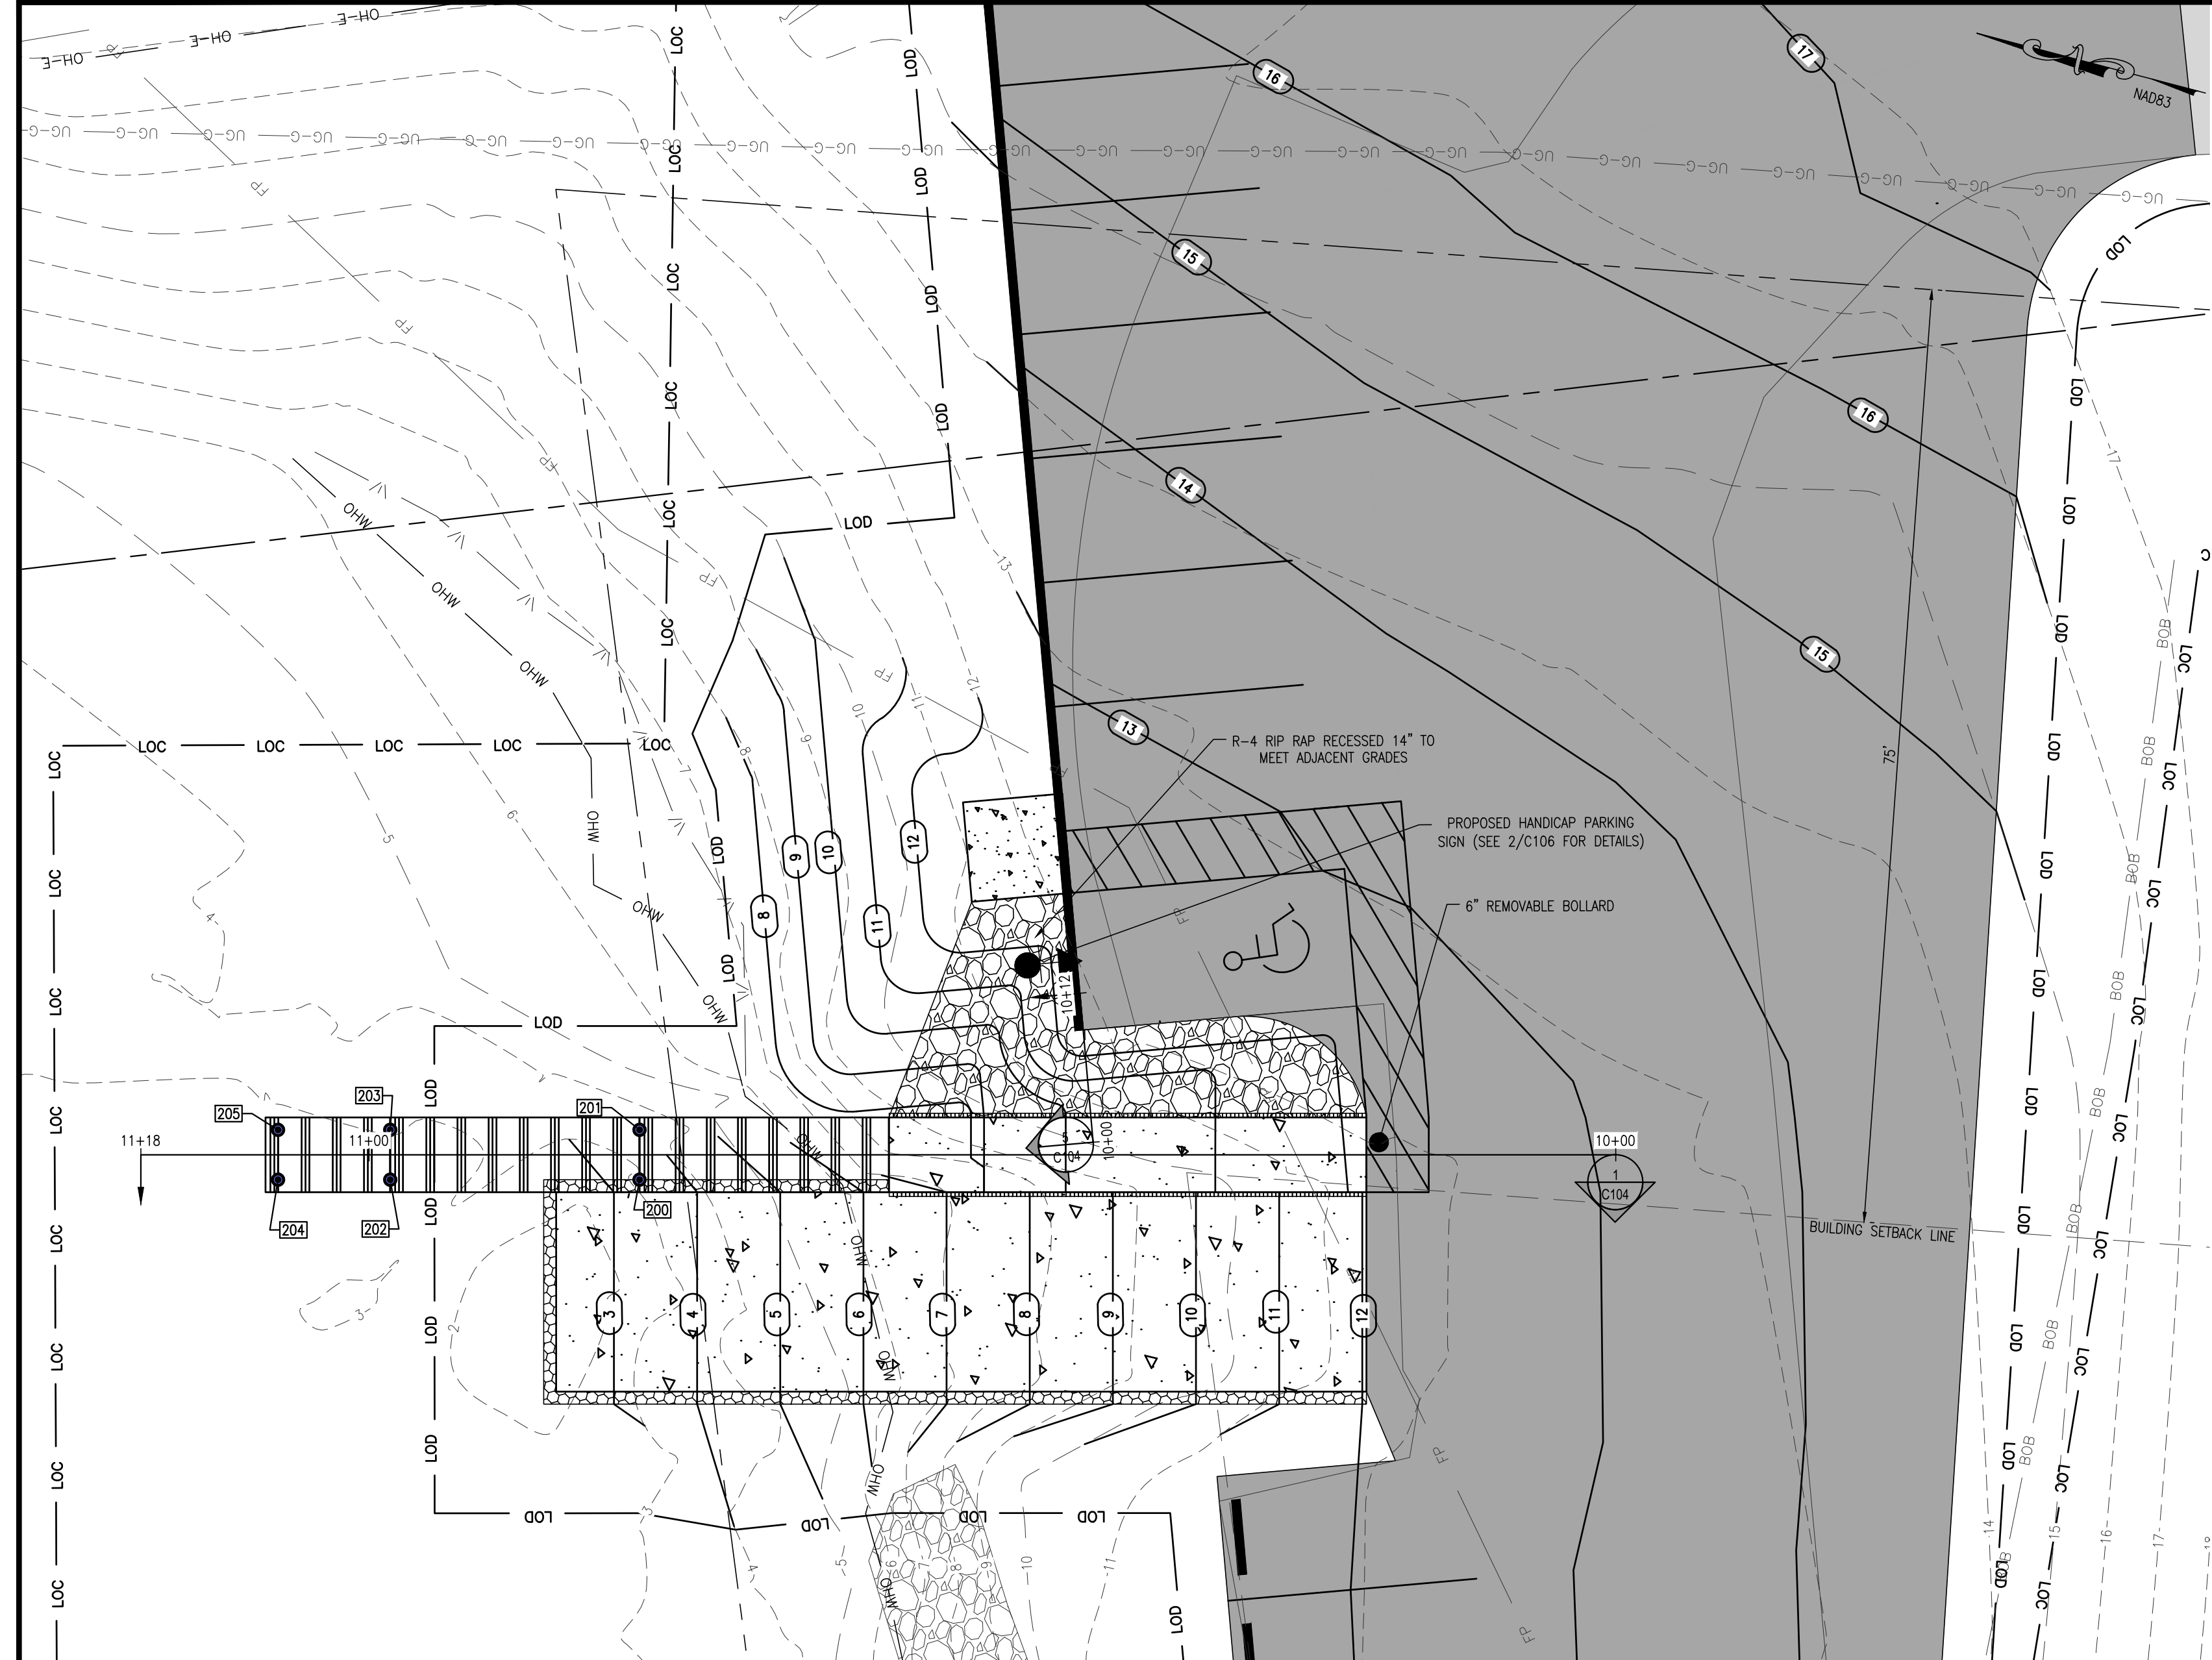


PLAN VIEW
SCALE: 1"=10'

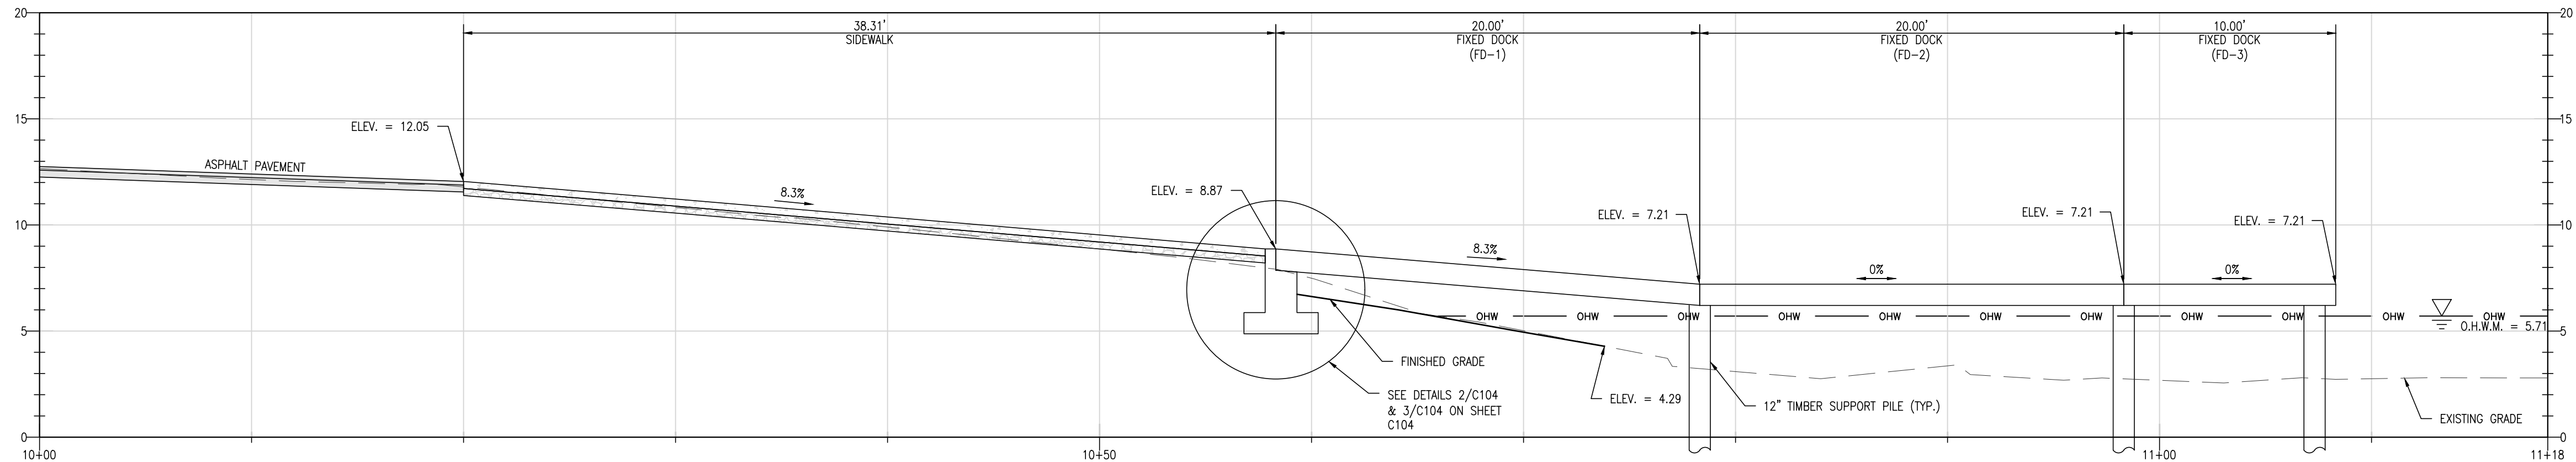

FIXED DOCK PROFILE
HORIZONTAL: 1"=5'
VERTICAL: 1"=5'

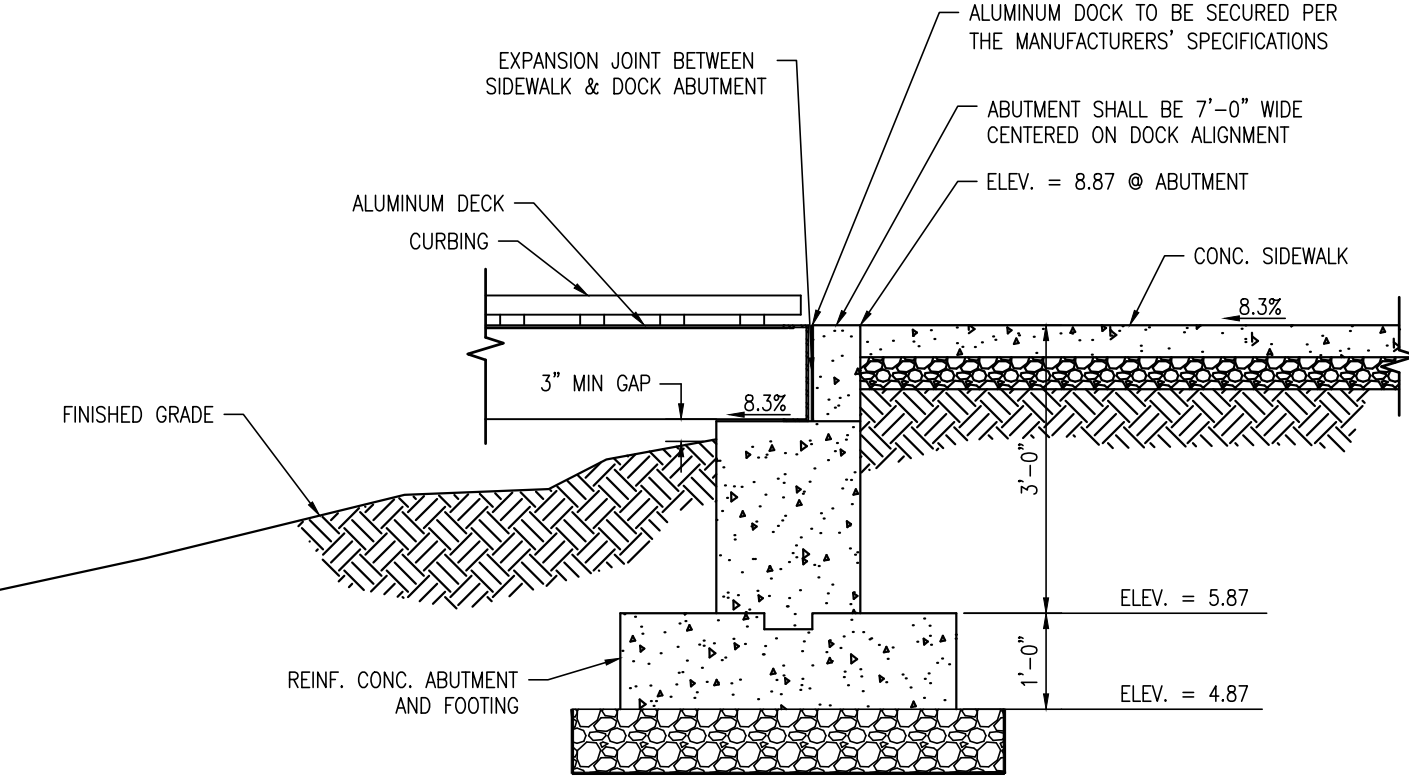

2 DOCK ABUTMENT / SIDEWALK INTERFACE
SCALE: 1/2"=1'

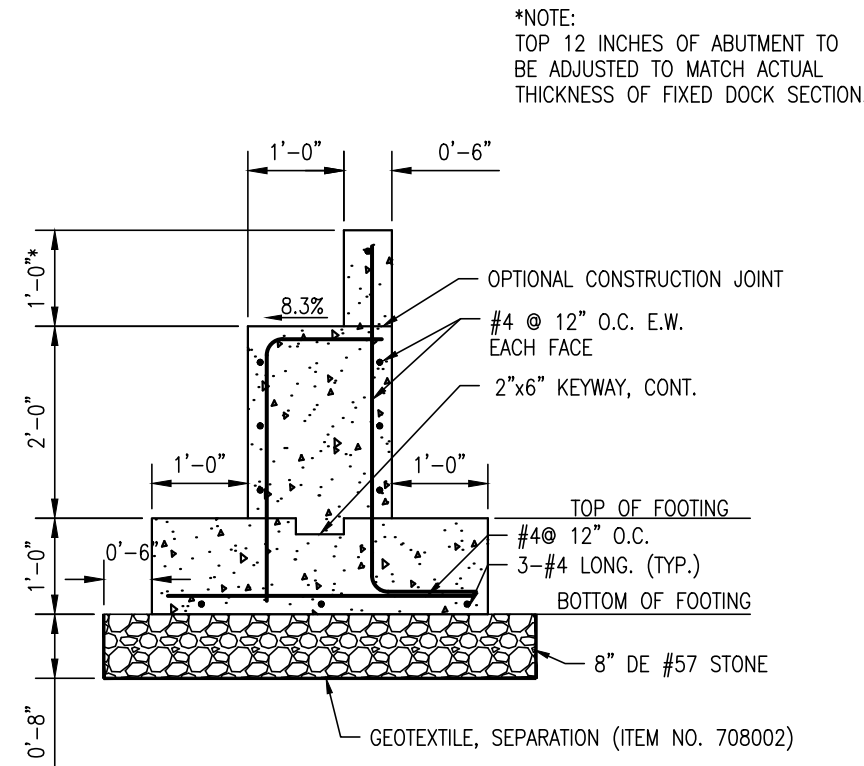


3 DOCK ABUTMENT
SCALE: 1/2"=1'

FIXED DOCK SUPPORT PILE LAYOUT						
POINT NO.	NORTHING	EASTING	TOP ELEV.*	EST. TIP ELEV.	PILE LENGTH**	MIN. EMBEDMENT***
200	452598.9977	607692.1160	6.80'	-22.0	30.0	25.0
201	452600.0040	607695.9910	6.80'	-22.0	30.0	25.0
202	452618.3556	607687.0890	6.80'	-22.0	30.0	25.0
203	452619.3615	607690.9623	6.80'	-22.0	30.0	25.0
204	452627.0673	607684.8263	6.80'	-22.0	30.0	25.0
205	452628.0729	607688.6996	6.80'	-22.0	30.0	25.0


* NOTE: CONTRACTOR SHALL VERIFY THE TOP OF PILE ELEVATIONS WITH THE FIELD CONDITIONS AND DOCK MANUFACTURER DESIGN REQUIREMENTS.

** NOTE: PILE LENGTH COLUMN INDICATES MINIMUM PILE LENGTH TO BE ORDERED BY THE CONTRACTOR. CONTRACTOR SHALL INSTALL PILE TO MEET MINIMUM EMBEDMENT AND ULTIMATE BEARING CAPACITY REQUIREMENTS. EXCESS PILE LENGTHS SHALL BE TRIMMED AS NEEDED.

*** NOTE: IF A VIBRATORY HAMMER IS USED IN-STEAD OF AN IMPACT HAMMER, AN ADDITIONAL FIVE (5) FEET OF EMBEDMENT SHALL BE REQUIRED. ADDITIONAL PILE LENGTH MAY BE ORDERED AT THE CONTRACTORS' DISCRETION AND EXPENSE TO ENSURE EMBEDMENT CRITERIA IS SATISFIED WHEN USING A VIBRATORY HAMMER.

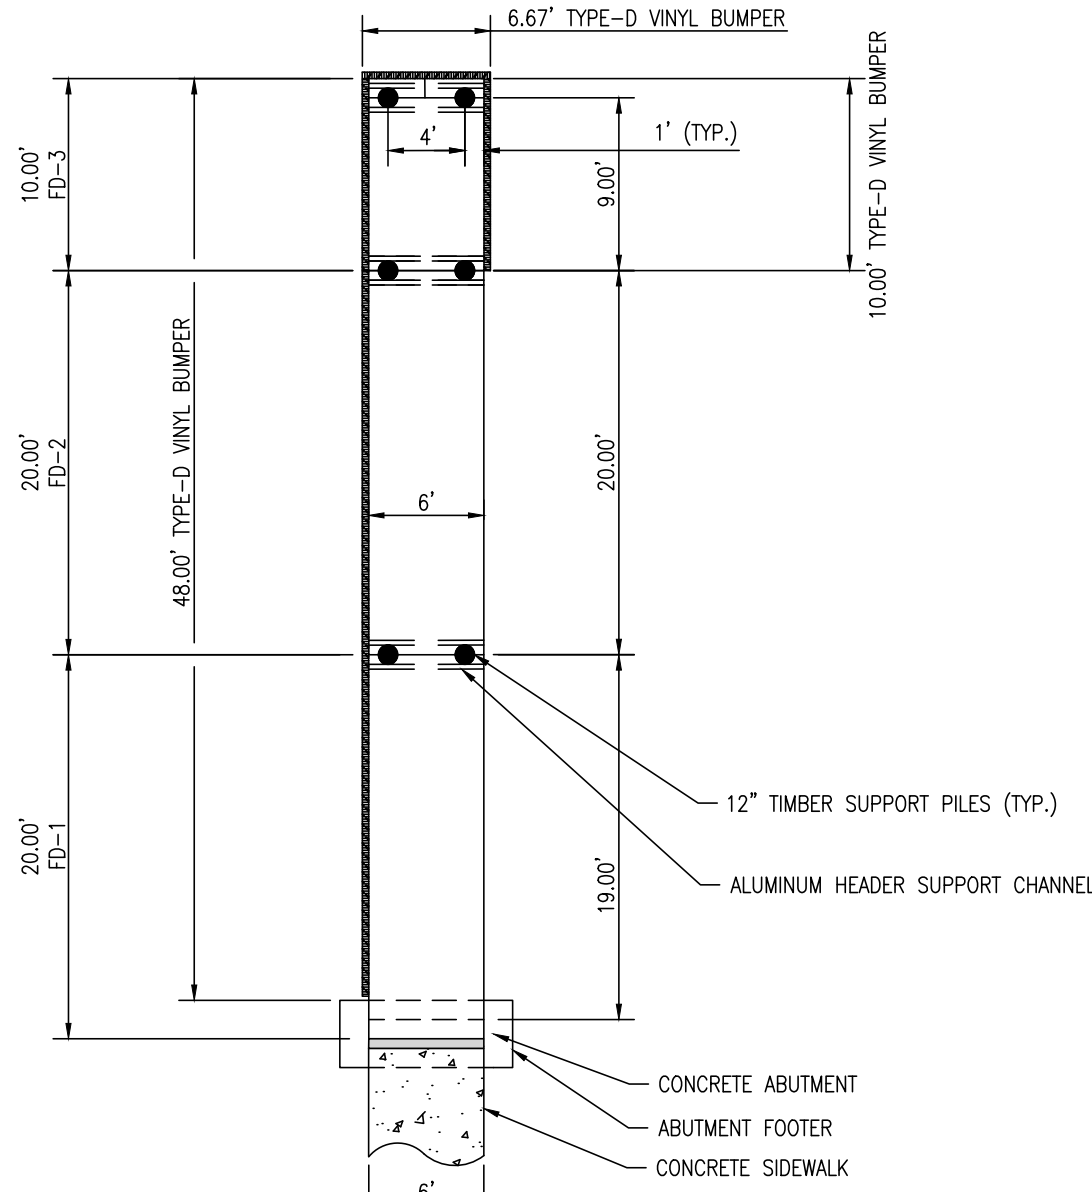

4 FIXED DOCK PLAN VIEW
SCALE: 1"=10'

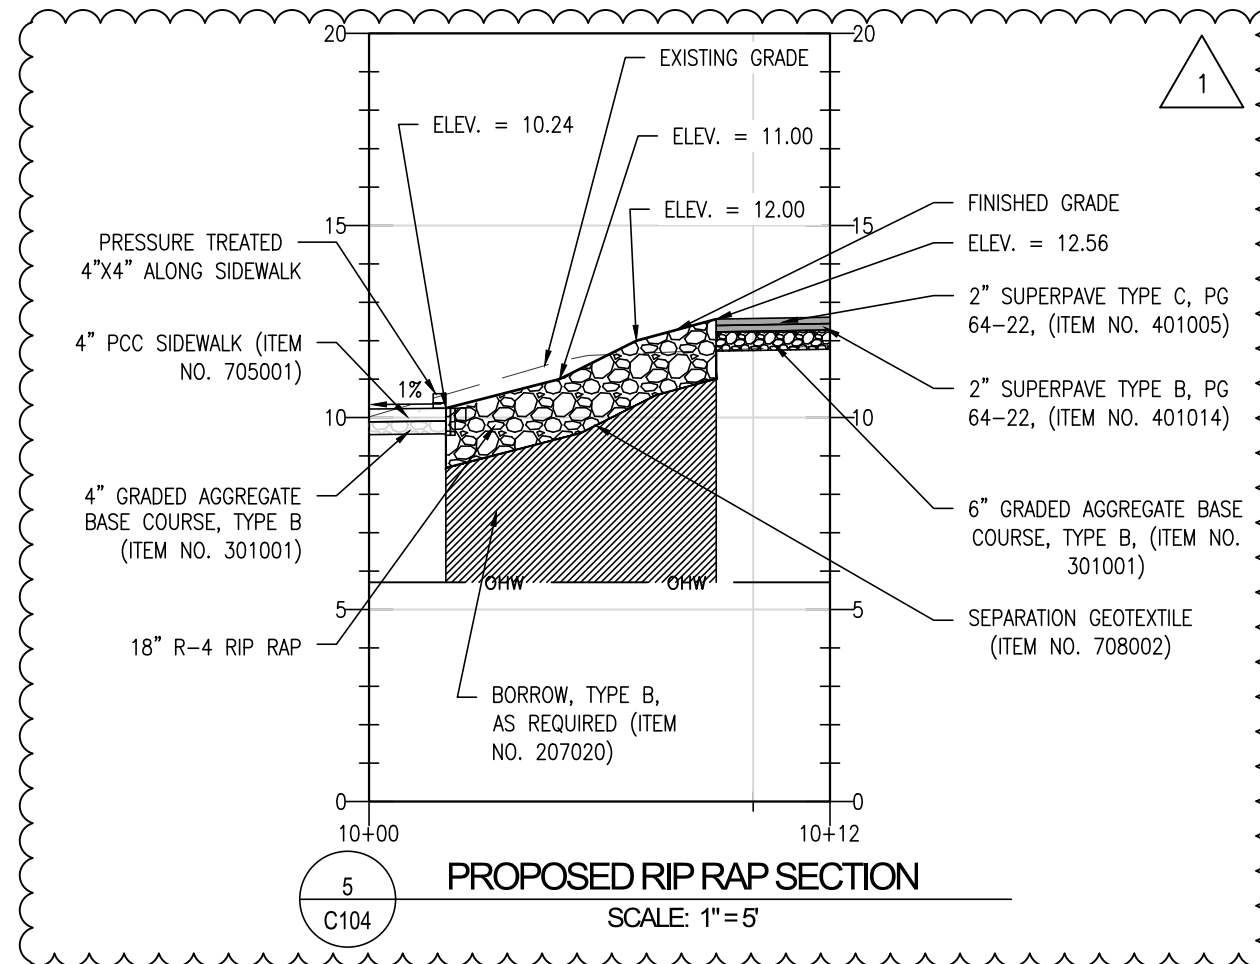

5 PROPOSED RIP RAP SECTION
SCALE: 1"=5'

FIXED DOCK NOTES:

1. FINAL DOCK CONFIGURATION TO BE CONFIRMED WITH OWNER.
2. DOCK DIMENSIONS SHOWN ARE NOMINAL FROM ALUMINUM TO ALUMINUM FRAME. FINAL FINISHED DIMENSIONS WILL VARY ACCORDING TO INSTALLED FENDERS & BUMPER.
3. TOP AND TIP ELEVATIONS OF TIMBER SUPPORT PILES FOR FIXED DOCK PROVIDED ON THIS SHEET.
4. ALL DOCKS, HEADER CHANNELS, RAILING, AND ANCILLARY ITEMS SHALL BE PROVIDED BY THE OWNER. HEADER CHANNELS SHALL BE ORDERED ONE (1) FOOT WIDER THAN THE PLAN LENGTH AND CUT IN THE FIELD BY THE CONTRACTOR.
5. FIXED DOCK SUPPORT PILES SHALL BE DRIVEN TO MINIMUM ULTIMATE BEARING CAPACITY OF 10.0 KIPS (AS DETERMINED BY THE ENGINEER) WHILE ALSO MEETING MINIMUM EMBEDMENT REQUIREMENTS.
6. WOOD PILES, CLASS B, SOUTHERN PINE MEETING REQUIREMENTS OF ASTM D25. PRESSURE IMPREGNATE WITH CHROMATED COPPER ARSENATE (CCA) IN ACCORDANCE WITH AMERICAN WOOD PRESERVERS ASSOCIATION (AWPA) STANDARD C3.
7. SEE MANUFACTURER'S SHOP DRAWINGS FOR ADDITIONAL ALUMINUM DOCK DETAILS.
8. REFER TO STRUCTURAL DETAILS FOR TIMBER PILE INSTALLATION NOTES.



This drawing is the property of Century Engineering, Inc. and is prepared for the exclusive use of its clients at the location indicated. No other use is authorized or intended.

CENTURY
ENGINEERING, INC.

ADDRESS:
550 BAY ROAD
DOVER, DE 19801
P: (802) 734-9188 F: (802) 734-4589
WEBSITE:
www.centuryeng.com
EMAIL:
cei@centuryeng.com

REVISIONS

ADDENDUM

DESCRIPTION	DATE
PROVIDED NEW DETAIL 5/C104, 11/03/2020	

CONSTRUCTION PLANS
FOR
DELAWARE DIVISION OF FISH & WILDLIFE
GARRISON'S LAKE BOAT RAMP RECONSTRUCTION
LITTLE CREEK HUNDRED, KENT COUNTY, DELAWARE

PROJECT

SHEET TITLE

FIXED DOCK DETAILS
SHEET

DIV. OF FISH AND WILDLIFE
BID SET

OCTOBER, 2020

DRAWN CHC/D/DESIGNER

ECM

AES

SCALE SHEET NO.







AS NOTED

PROJECT NO.

17501343

C104

C:\Projects\17501340 [DWG] 2017 Engineering [C:\Users\jld\OneDrive - Century Engineering, Inc. Desktop\17501340 - Boat Ramp\17501340 - Boat Ramp.dwg, 11/3/2020, 3:59 PM

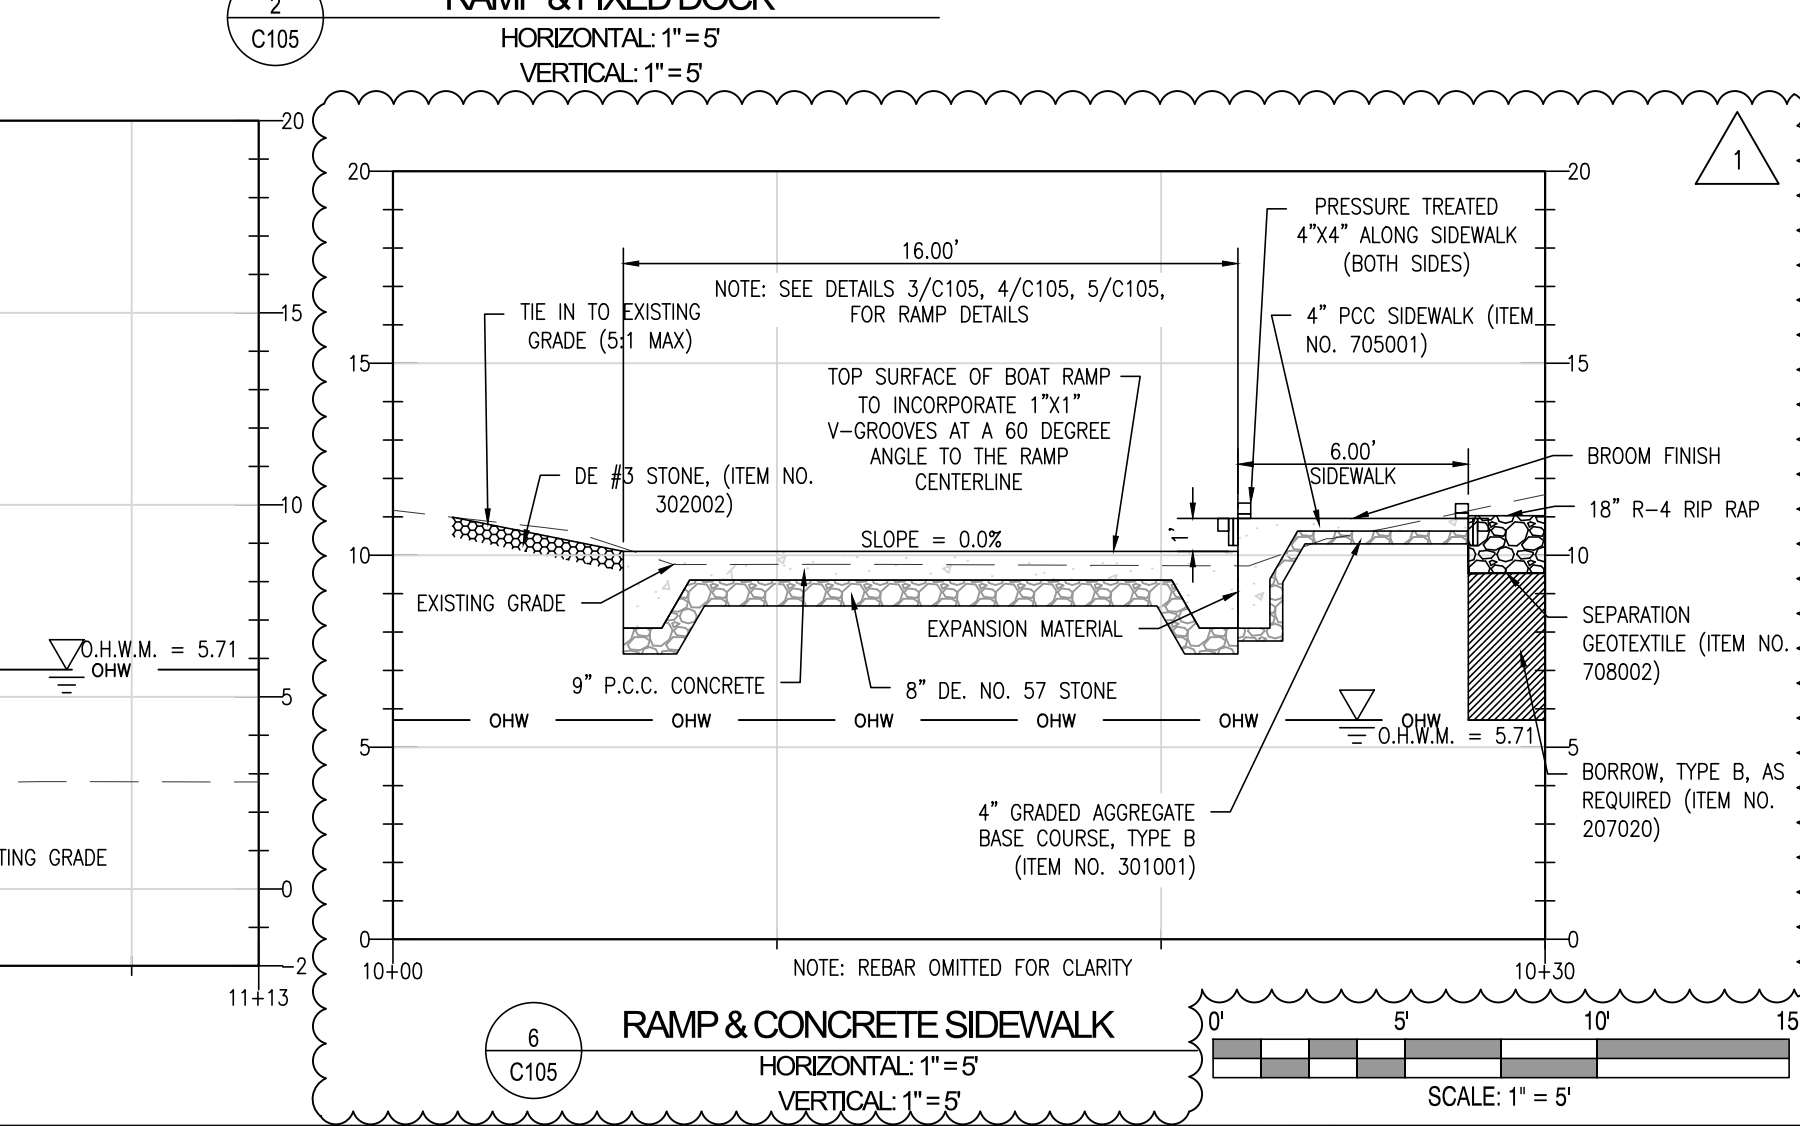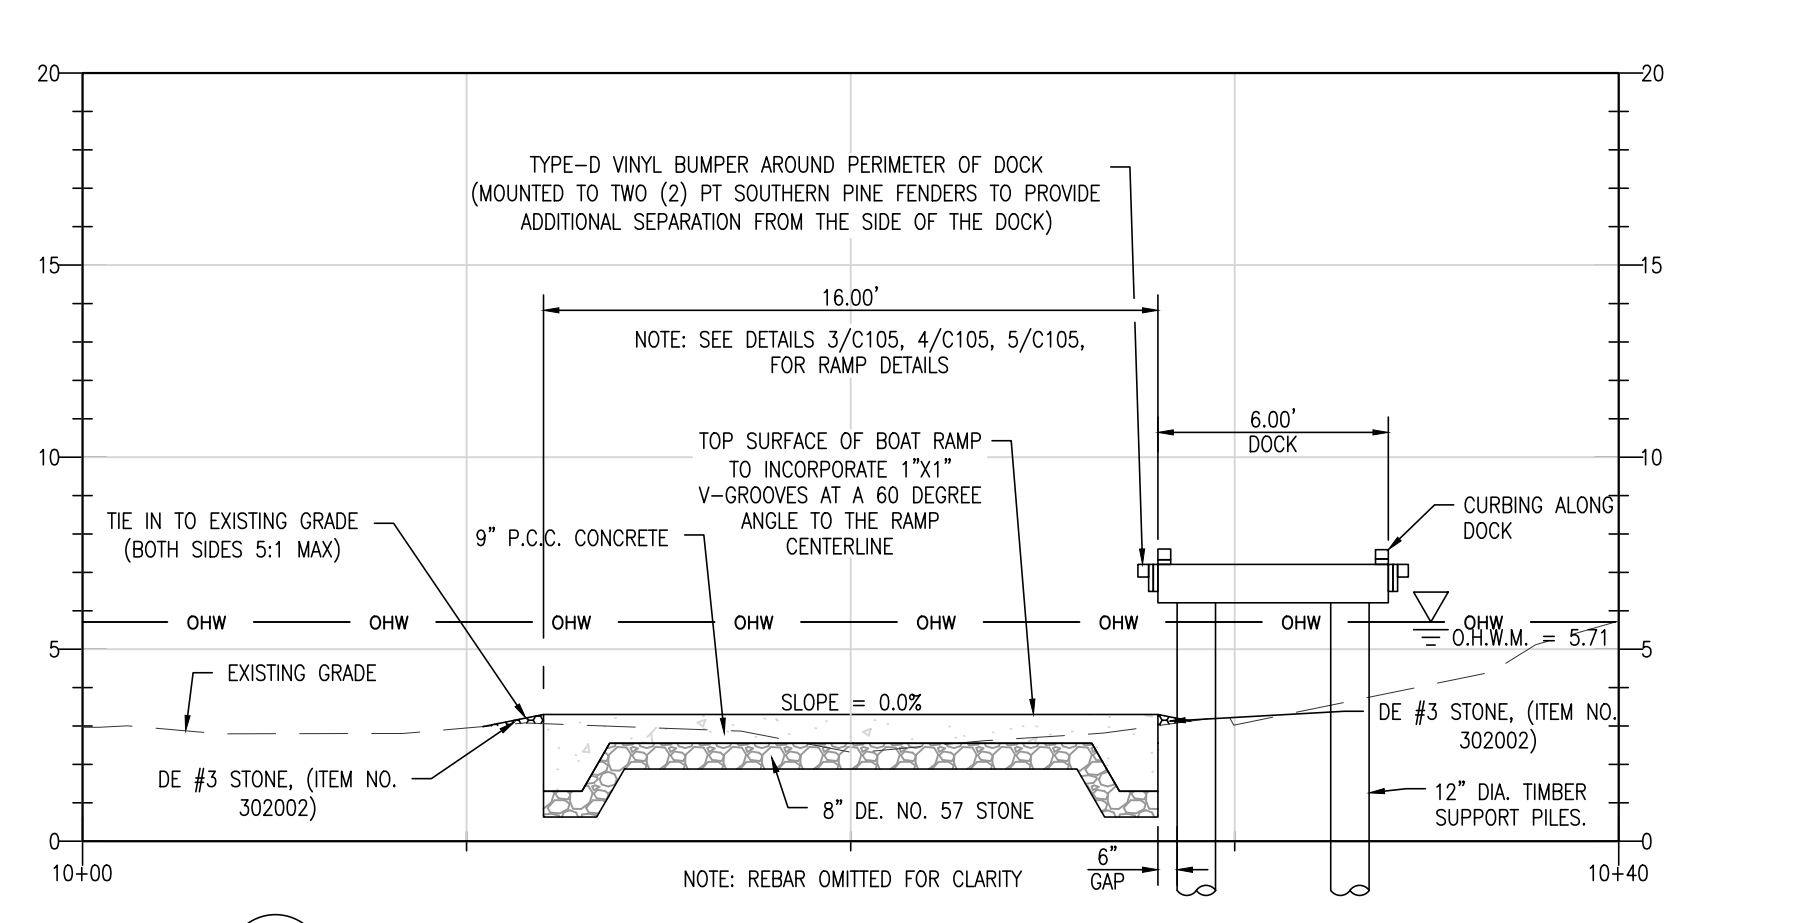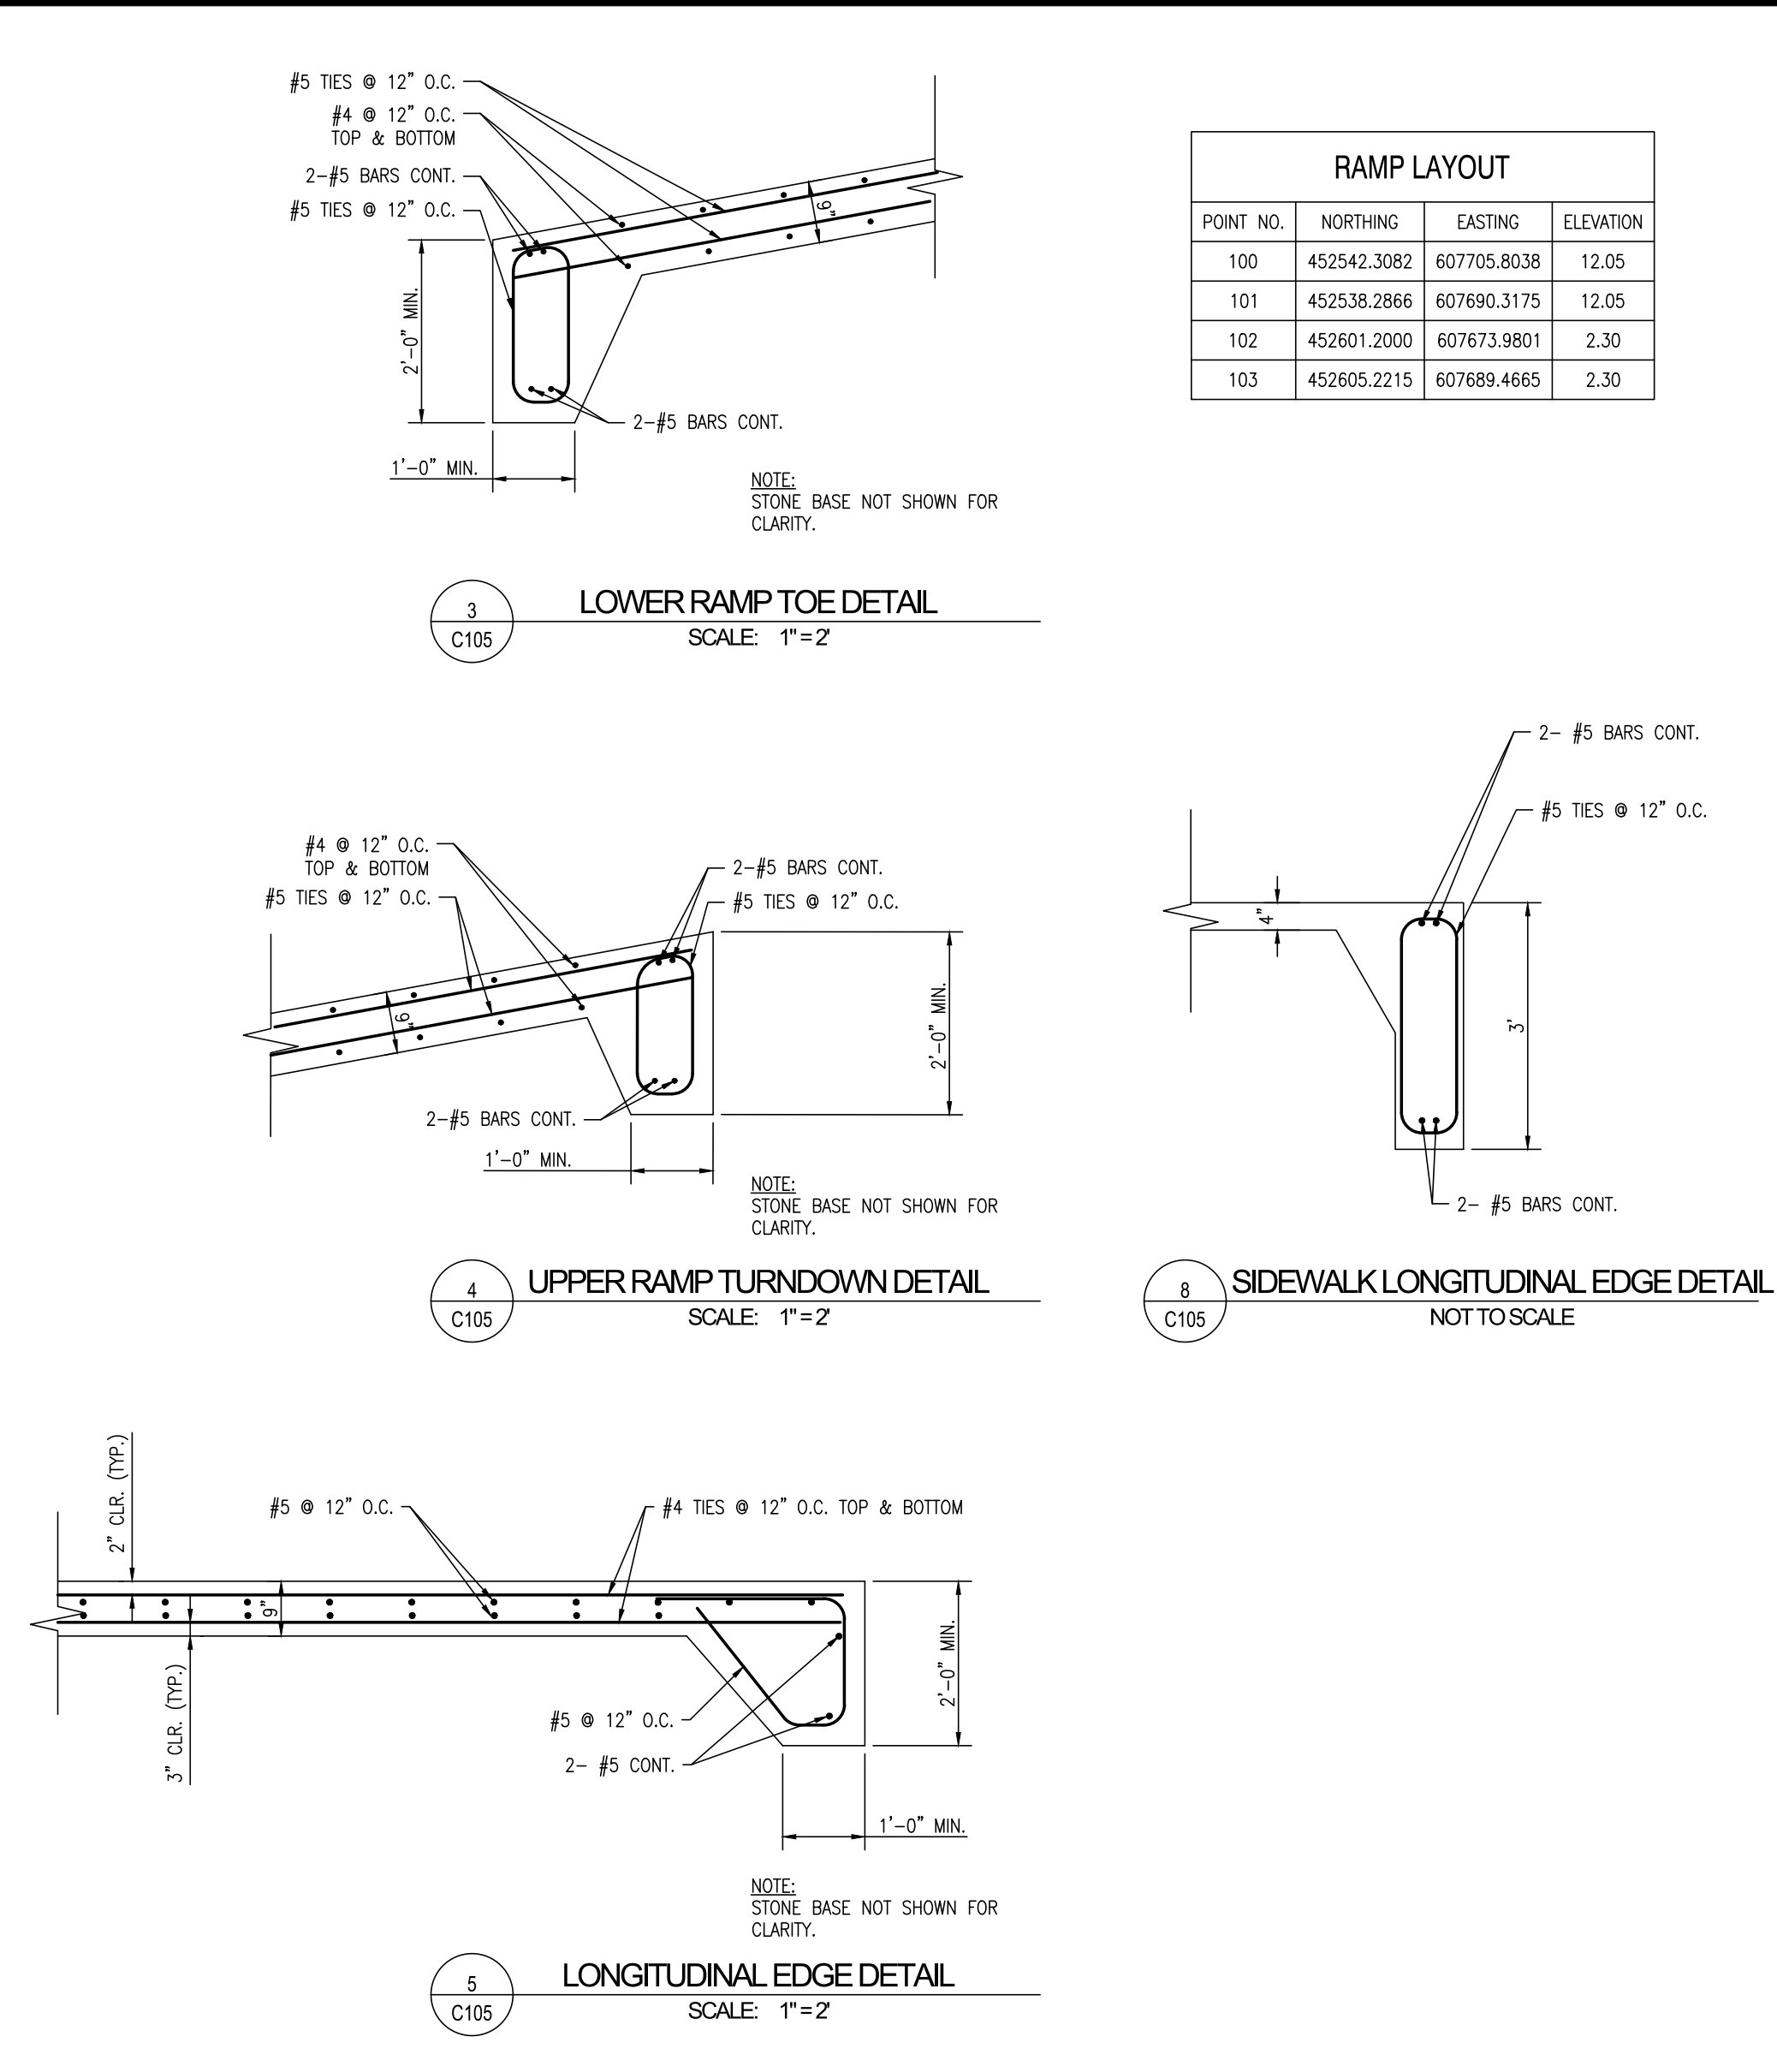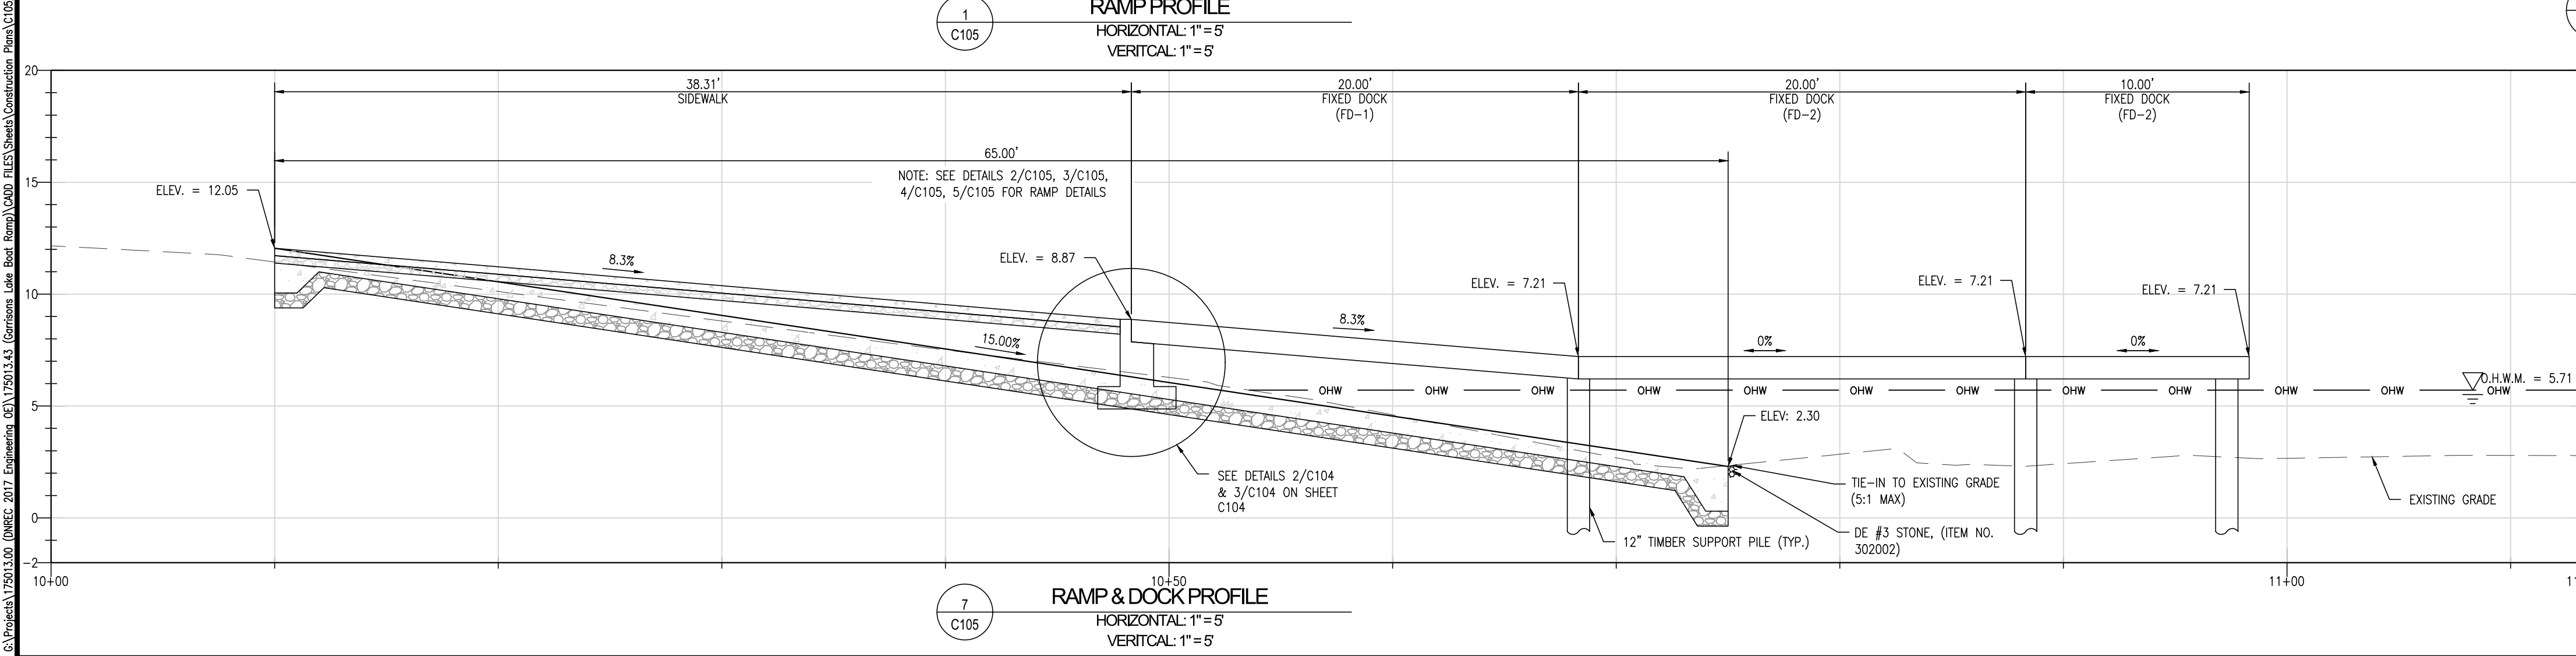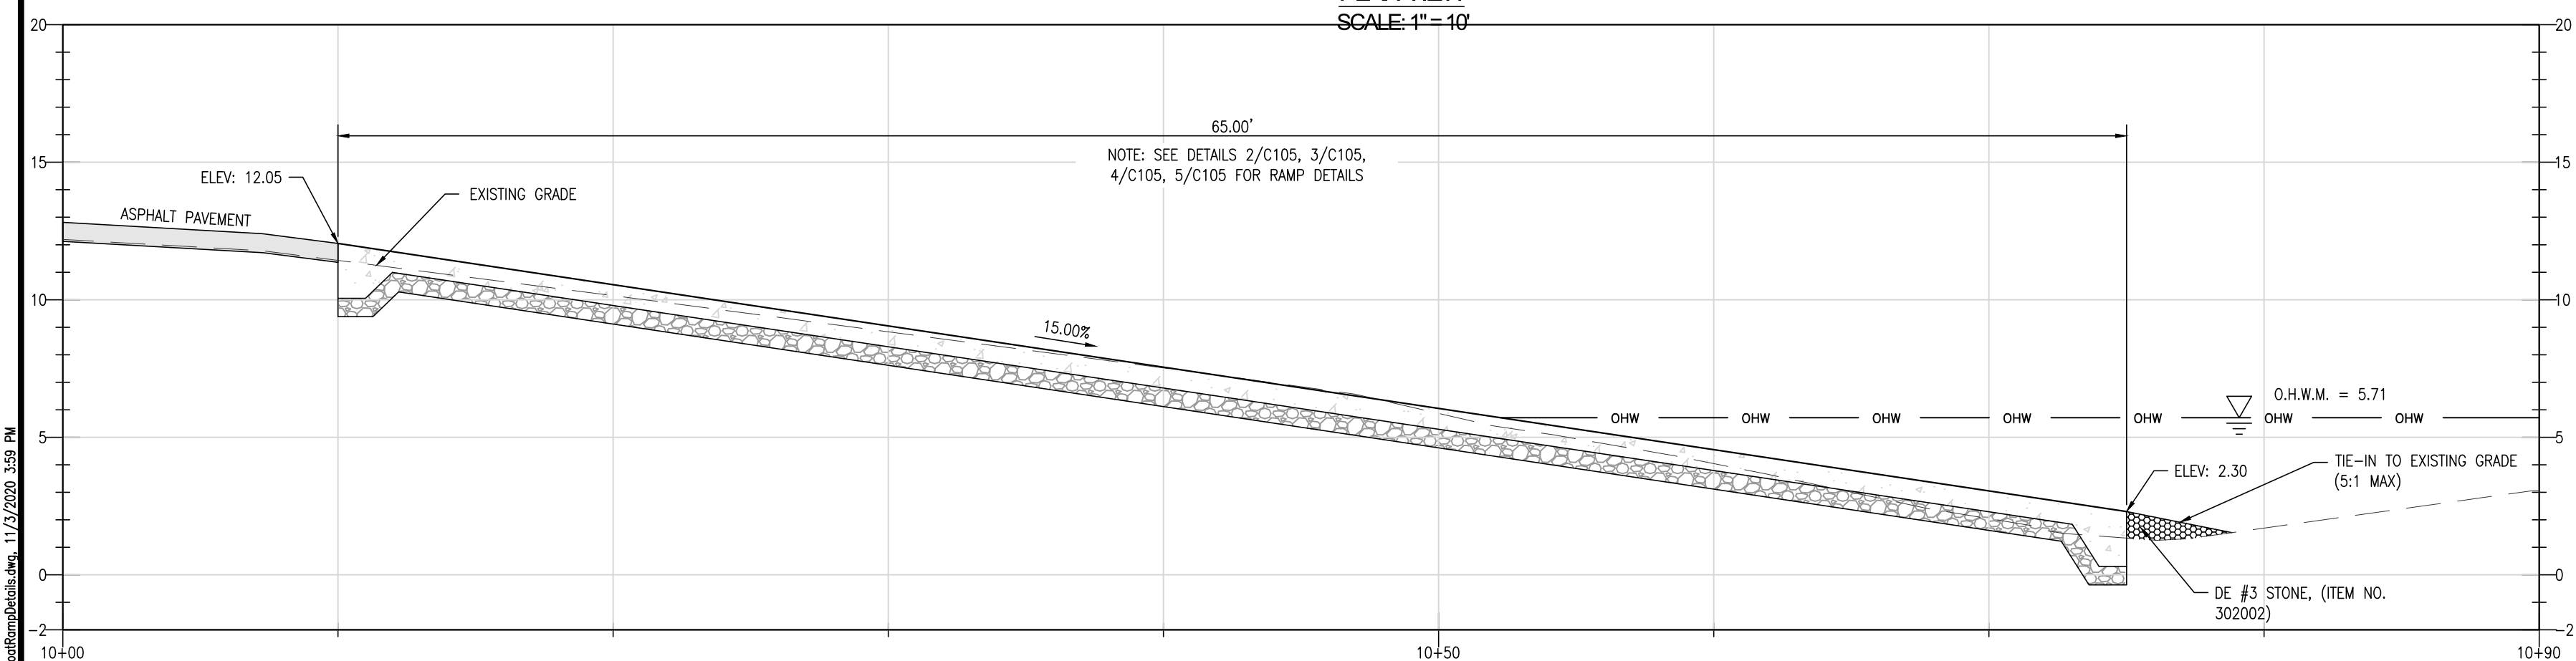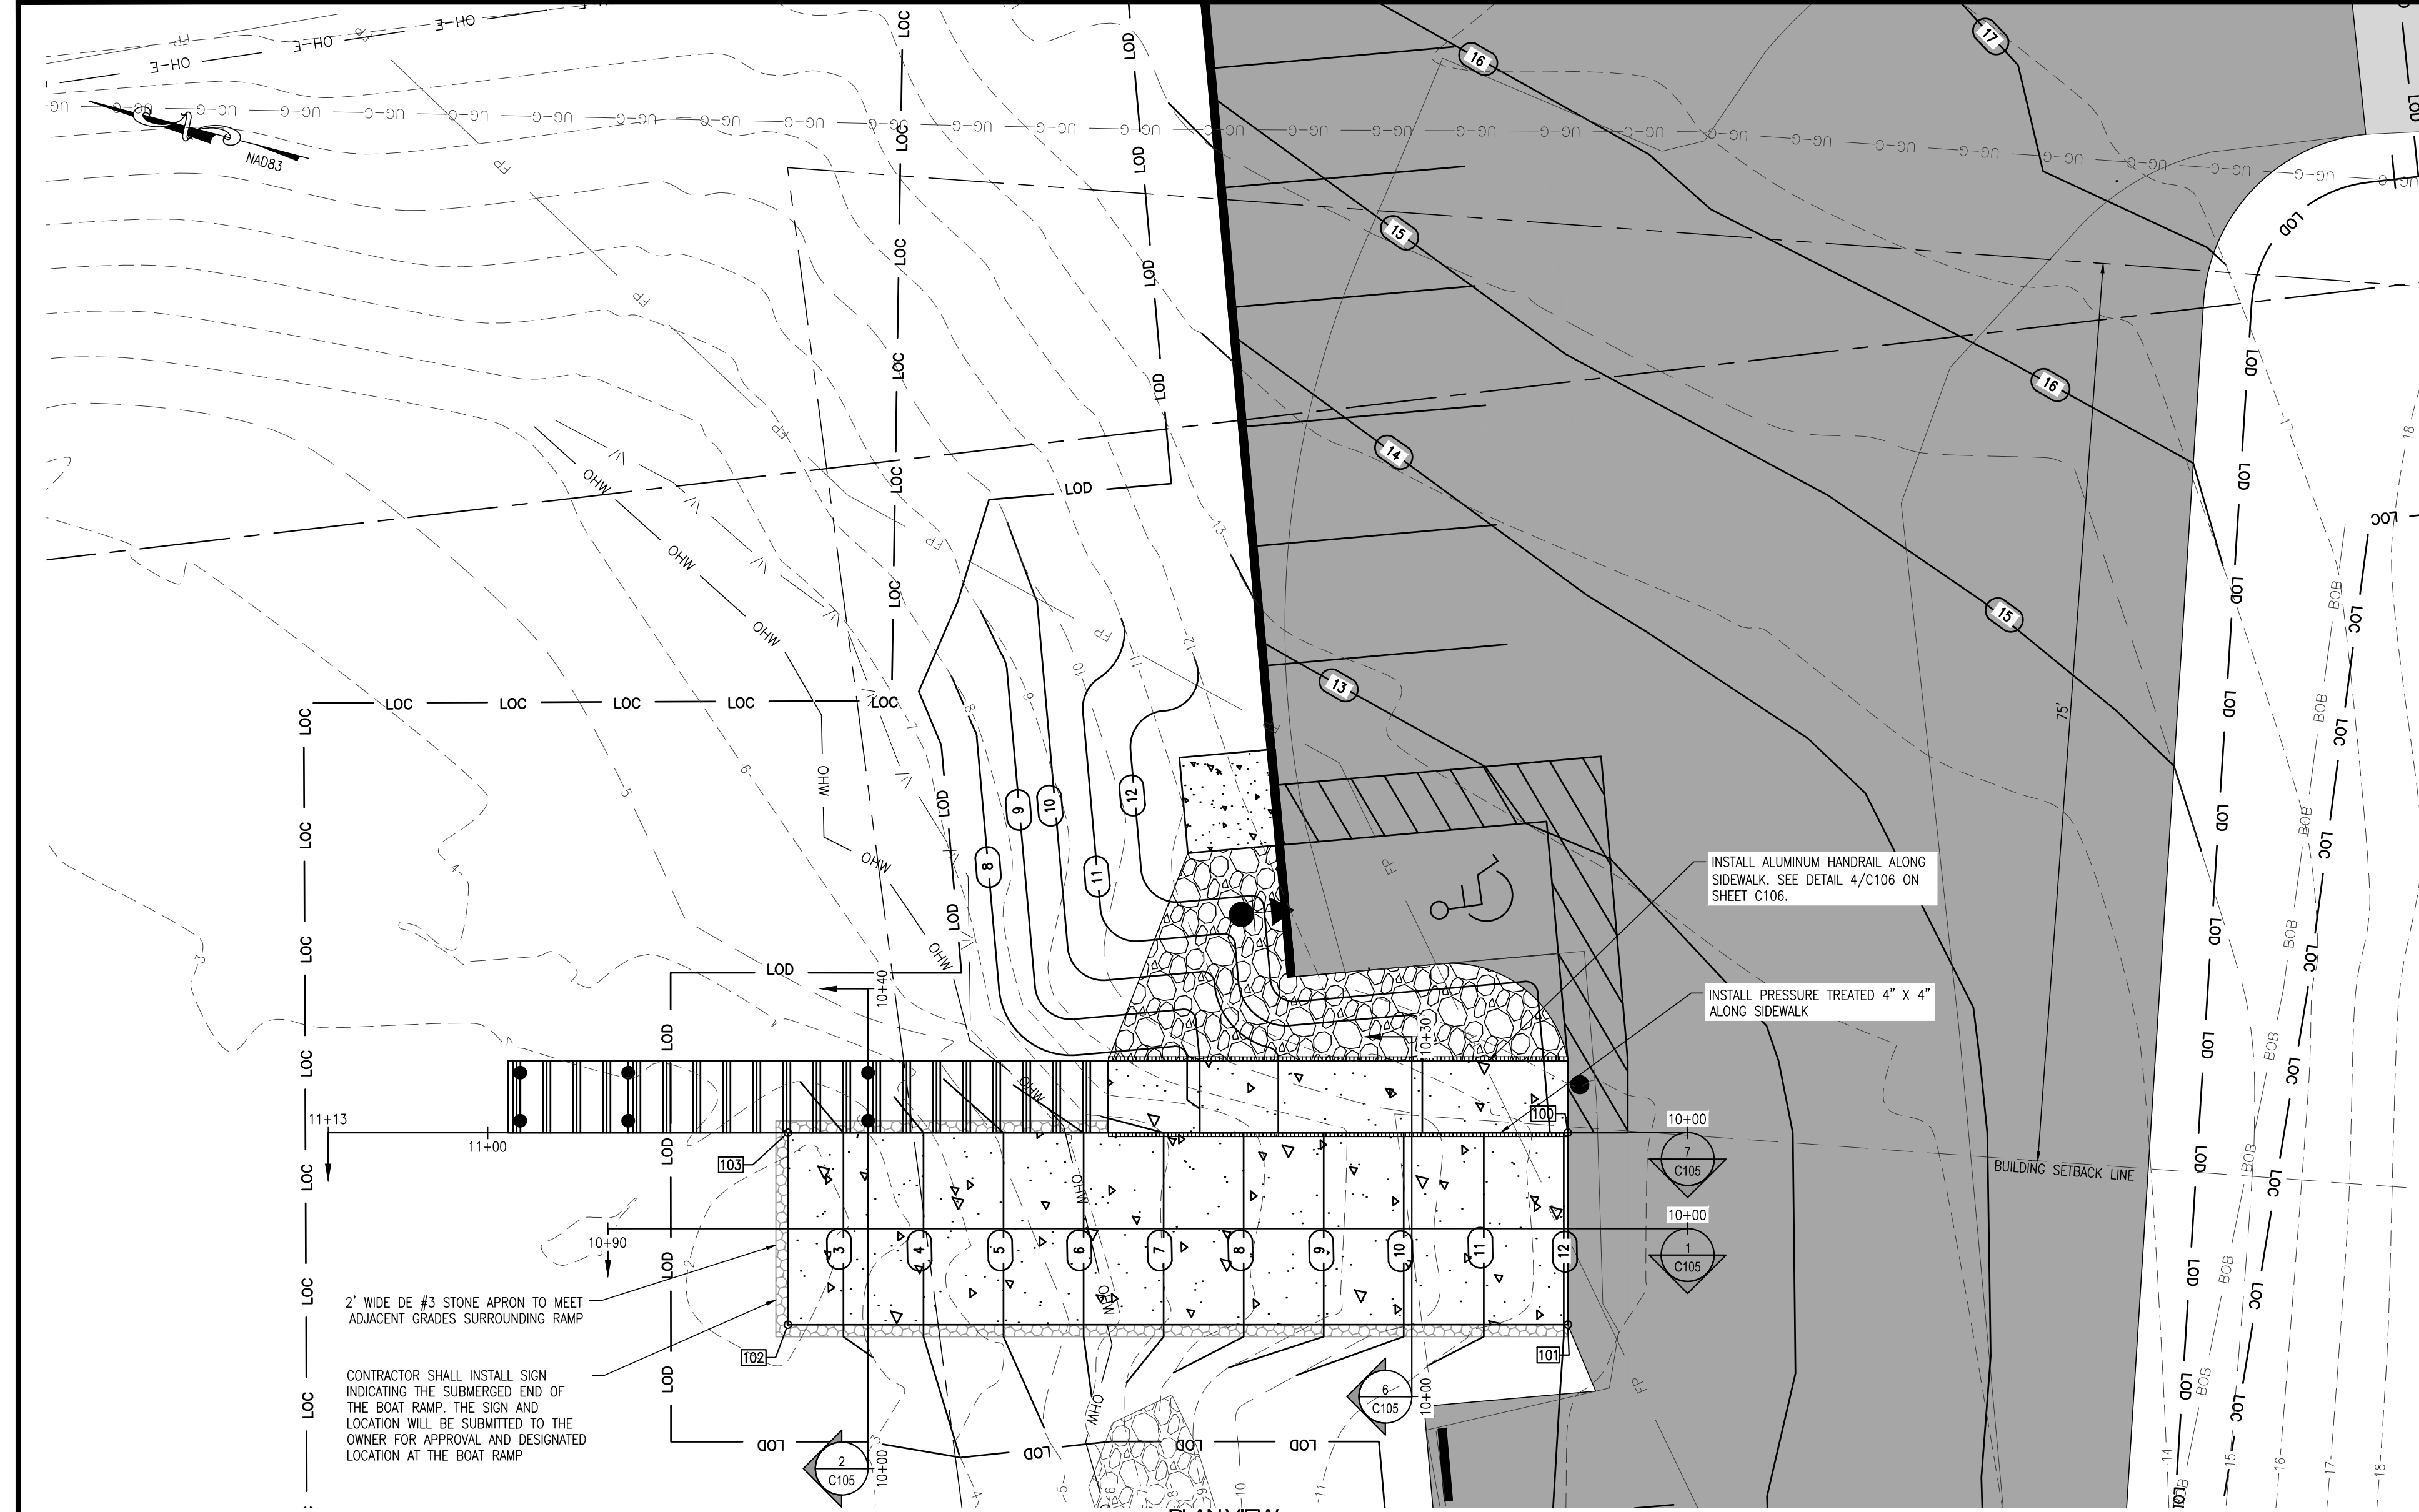

This drawing is the property of Century Engineering, Inc. and is prepared for the exclusive use of its clients at the location indicated. No other use is authorized or intended.

CENTURY
ENGINEERING, INC.

ADDRESS: 550 BAY ROAD
DOVER, DE 19801
P: (302) 734-9188 F: (302) 734-4589

WEBSITE: www.centuryeng.com

EMAIL: cel@centuryeng.com

REVISIONS	
ADDENDUM	
DESCRIPTION	DATE
PROVIDED NEW DETAIL 6/C105, 11/03/2020	

CONSTRUCTION PLANS
FOR
DELAWARE DIVISION OF FISH & WILDLIFE
GARRISON'S LAKE BOAT RAMP RECONSTRUCTION
LITTLE CREEK HUNDRED, KENT COUNTY, DELAWARE

PROJECT

SHEET TITLE

BOAT RAMP DETAILS SHEET

DIV. OF FISH AND WILDLIFE
BID SET

OCTOBER, 2020

DRAWN CHK'D/DISIGNER

ECM AES

SCALE SHEET NO.

AS NOTED


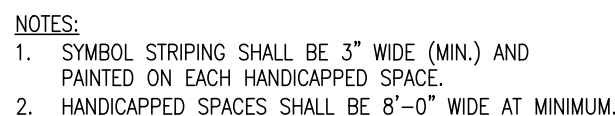
PROJECT NO. 17501343

C105

Century
ENGINEERING, INC.


EMAIL: cei@centuryeng.com

P: (302) 734-9188 F: (302) 734-4589



ITEM NO.	PART NO.	DESCRIPTION	MATERIAL
1		1½" SCH40 ALUM. PIPE TOP RAIL	6063-T6
2		1½" SCH40 ALUM. PIPE POST	6061-T6
3		1½" SCH40 ALUM. PIPE INTERMEDIATE RAIL	6063-T6
4	ARS 305/304	5" DIA. CAST ALUM. POST SHOE	

ITEM NO.	PART NO.	DESCRIPTION	MATERIAL
1		1½" SCH40 ALUM. PIPE TOP RAIL	6063-T6
2		1½" SCH40 ALUM. PIPE POST	6061-T6
3		1½" SCH40 ALUM. PIPE INTERMEDIATE RAIL	6063-T6
4	ARS 305/304	5" DIA. CAST ALUM. POST SHOE	

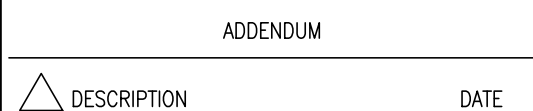

PROJECT

CONSTRUCTION DETAILS

DRAWN	CHK'D/DESIGNER
-------	----------------

SCALE SHEET NO.

C100

C106



Standard Detail & Specifications

Construction Site Waste Mgt & Spill Control

DATA TO BE PROVIDED

Volume of Potential Pollution

Height of containment

Area of containment

Volume of containment

Fuel Tank

Double layer plastic sheeting, or approved equal

Min. 9" compost log or DE# 3

Stone berm

Stake as required per compost log manufacturer guidelines

Double layer plastic sheeting

Fuel Tank

Spill containment Area

Source:

Delaware ESC Handbook

Symbol:

Detail No.

DE-ESC-3.6.1

Sheet 1 of 5

Effective FEB 2019

Standard Detail & Specifications

Construction Site Waste Mgt & Spill Control

Pollution Prevention – Spill Prevention

1. Fueling should only take place in signed designated areas, away from downstream drainage facilities and watercourses.

2. Fueling must be with nozzles equipped with automatic shut-off to control drips. Do not top off.

3. Protect the areas where equipment or vehicles are being repaired, maintained, fueled or parked from storm water run-on and runoff.

4. Use barriers such as berms to prevent storm water run-on and runoff, and to contain spills.

5. Place a "Fueling Area" sign next to each fueling area.

6. Store hazardous materials such as fuel, solvents, oil and chemicals in secondary containment.

7. Inspect vehicles and equipment for leaks on each day of use. Repair fluid and oil leaks immediately.

8. Absorbent spill clean-up materials and spill kits must be available in fueling areas and on fuel trucks.

9. If fueling is to take place at night, make sure the fueling area is sufficiently illuminated.

10. Properly dispose of used oil, fluids, lubricants and spill clean-up materials.

CLEAN UP SPILLS

1. If it is safe to do so, immediately contain and clean up any chemical and/or hazardous material spills.

2. Properly dispose of used oil, fluids, lubricants and spill clean-up materials.

3. Do not bury spills or wash them down with water.

LEAKS AND DRIPS

1. Use drip pans or absorbent pads at all times. Place under and around leaky equipment.

2. Do not allow oil, grease, fuel or chemicals to drip onto the ground.

3. Have spill kits and clean up material on-site.

4. Repair leaky equipment promptly or remove problem vehicles and equipment from the site. Clean up contaminated soil immediately.

5. Store contaminated waste in sealed containers constructed of suitable material. Label these containers properly.

6. Clean up all spills and leaks. Promptly dispose of waste and spent clean up materials.

Source:

Delaware ESC Handbook

Symbol:

Detail No.

DE-ESC-3.6.1

Sheet 2 of 5

Effective FEB 2019

Standard Detail & Specifications

Construction Site Waste Mgt & Spill Control

Notes:

The Construction Site Pollution Prevention Plan should include the following elements:

1. Material Inventory

Document the storage and use of the following materials:

a. Concrete

b. Detergents

c. Paints (enamel and latex)

d. Cleaning solvents

e. Pesticides

f. Wood scraps

g. Fertilizers

h. Petroleum based products

2. Good housekeeping practices

a. Store only enough product required to do the job.

b. All materials shall be stored in a neat, orderly manner in their original labeled containers and covered.

c. Substances shall not be mixed.

d. When possible, all of a product shall be used up prior to disposal of the container.

e. Manufacturers' instructions for disposal shall be strictly adhered to.

f. The site foreman shall designate someone to inspect all BMPs daily.

3. Waste management practices

a. All waste materials shall be collected and stored in securely lidded dumpsters in a location that does not drain to a waterbody.

b. Waste materials shall be salvaged and/or recycled whenever possible.

c. The dumpsters shall be emptied a minimum of twice per week, or more if necessary. The licensed trash hauler is responsible for cleaning out dumpsters.

Source:

Adapted from USEPA Pub. 840-B-92-002

Symbol:

Detail No.

DE-ESC-3.6.1

Sheet 3 of 5

Effective FEB 2019

Standard Detail & Specifications

Construction Site Waste Mgt & Spill Control

Notes (cont.)

d. Trash shall be disposed of in accordance with all applicable Delaware laws.

e. Trash cans shall be placed at all lunch spots and littering is strictly prohibited. Recycle bins shall be placed near the construction trailer.

f. If fertilizer bags can not be stored in a weather-proof location, they shall be kept on a pallet and covered with plastic sheeting which is overlapped and anchored.

4. Equipment maintenance practices

a. If possible, equipment should be taken to off-site commercial facilities for washing and maintenance.

b. If performed on-site, vehicles shall be washed with high-pressure water spray without detergents in an area contained by an impervious berm.

c. Drip pans shall be used for all equipment maintenance.

d. Equipment shall be inspected for leaks on a daily basis.

e. Washout from concrete trucks shall be disposed of in a temporary pit for hardening and proper disposal.

f. Fuel nozzles shall be equipped with automatic shut-off valves.

g. All used products such as oil, antifreeze, solvents and tires shall be disposed of in accordance with manufacturers' recommendations and local, state and federal laws and regulations.

5. Spill prevention practices

a. Potential spill areas shall be identified and contained in covered areas with no connection to the storm drain system.

b. Warning signs shall be posted in hazardous material storage areas.

c. Preventive maintenance shall be performed on all tanks, valves, pumps, pipes and other equipment as necessary.

d. Low or non-toxic substances shall be prioritized for use.

Source:

Adapted from USEPA Pub. 840-B-92-002

Symbol:

Detail No.

DE-ESC-3.6.1

Sheet 4 of 5

Effective FEB 2019

Standard Detail & Specifications

Construction Site Waste Mgt & Spill Control

Notes (cont.)

e. Contact information for reporting spills through the DNREC 24-Hour Toll Free Number shall be prominently posted.

6. Education

a. Best management practices for construction site pollution control shall be a part of regular progress meetings.

b. Information regarding waste management, equipment maintenance and spill prevention shall be prominently posted in the construction trailer.

CONTACT INFORMATION

DNREC 24-Hour Toll Free Number

800-662-8802

DNREC Solid & Hazardous Waste Management Section

302-739-9403

Source:

Adapted from USEPA Pub. 840-B-92-002

Symbol:

Detail No.

DE-ESC-3.6.1

Sheet 5 of 5

Effective FEB 2019

Standard Detail & Specifications

Sensitive Area Protection

Drip line

Protective device

Limit of disturbance

Proposed grading

5"

Min.

"5" min. setback applies to all sensitive areas covered by this specification.

Location of Sensitive Area Protection

Drip line

Snow fence

Board fence

Cord fence

Plastic fence

Methods of Sensitive Area Protection

Source:

Adapted from VA ESC Handbook

Symbol:

Detail No.

DE-ESC-3.7.2

Sheet 1 of 3

Effective FEB 2019

Standard Detail & Specifications

Sensitive Area Protection

Construction Notes:

Fencing shall be installed at the extents of all sensitive areas. For trees, the fencing shall be installed outside the dripline (mature canopy) and at no time within 5 feet of the trunk. Personnel must be instructed to honor protective devices. The devices described are suggested only, and are not intended to exclude the use of other devices which will protect the trees to be retained. If silt fence is to be used for demarcation purposes, appropriate signage shall be provided a minimum of every 20 feet denoting the area as a sensitive area protection zone.

Materials:

1. Snow Fence - Standard 40-inch high snow fence shall be placed at the limits of clearing or construction on standard steel posts set 6 feet apart.

2. Board Fence - Board fencing consisting of 4-inch square posts set securely in the ground and protruding at least 4 feet above the ground shall be placed at the limits of clearing with a minimum of two horizontal boards between posts. For tree protection, if it is not practical to erect a fence at the drip line, construct a triangular fence nearer the trunk. The limits of clearing will still be located at the drip line, since the root zone within the drip line will still require protection.

3. Plastic Fencing - 40-inch high "international orange" plastic (polyethylene) web fencing secured to conventional metal "T" or "U" posts driven to a minimum depth of 18 inches on 6-foot minimum centers shall be installed at the limits of clearing. The fence should have the following minimum physical qualities:

a. Tensile yield: Average 2,000 lbs. per 4-foot width (ASTM D638)

b. Ultimate tensile yield: Average 2,900 lbs. per 4-foot width (ASTM D638)

c. Elongation at break (%): Greater than 1000% (ASTM D638)

d. Chemical resistance: Inert to most chemicals and acids

Source:

Adapted from VA ESC Handbook

Symbol:

Detail No.

DE-ESC-3.7.2

Sheet 2 of 3

Effective FEB 2019

Standard Detail & Specifications

Sensitive Area Protection

4. Cord Fence - Posts with a minimum size of 2 inches square or 2 inches in diameter set securely in the ground and protruding at least 4 feet above the ground shall be placed at the limits of clearing with two rows of cord 1/4-inch or thicker at least 2 feet apart running between posts with strips of colored surveyor's flagging tied securely to the string at intervals no greater than 3 feet.

5. Earth Berms - Temporary earth berms shall be constructed according to specifications for a Temporary Earth Dike with the base of the berm on the sensitive area side located along the limits of clearing. Earth berms may not be used for this purpose if their presence will conflict with drainage patterns.

6. Trunk Armoring (Tree Protection Only) - As a last resort, a tree trunk can be armored with burlap wrapping and 2-inch studs wired vertically no more than 2 inches apart to a height of 5 feet encircling the trunk. If this alternative is used, the root zone within the drip line will still require protection. Nothing should ever be nailed to a tree.

Maintenance:

Fencing and armoring devices shall be in place before any excavation or grading is begun, shall be kept in good repair for the duration of construction activities, and shall be the last items removed during the final cleanup after the completion of the project.

Source:

Adapted from VA ESC Handbook

Symbol:

Detail No.

DE-ESC-3.7.2

Sheet 3 of 3

Effective FEB 2019

REVISIONS	
ADDENDUM	
△ DESCRIPTION	DATE

CONSTRUCTION PLANS
FOR
DELAWARE DIVISION OF FISH & WILDLIFE
GARRISON'S LAKE BOAT RAMP RECONSTRUCTION
LITTLE CREEK HUNDRED, KENT COUNTY, DELAWARE

PROJECT	SHEET TITLE
	EROSION & SEDIMENT CONTROL DETAILS
DIV. OF FISH AND WILDLIFE	BID SET
OCTOBER, 2020	
DRAWN	CHK'D/DISIGNER
ECM	AES
SCALE	SHEET NO.
AS NOTED	C107
PROJECT NO.	17501343

Source: Delaware ESC Handbook & Filtrex™ International	Symbol:	Detail No. DE-ESC-3.4.5 Sheet 1 of 3 Effective FEB 2019
--	---------	---


Source: Delaware ESC Handbook	Symbol:	Detail No. DE-ESC-3.4.3 Sheet 1 of 4 Effective FEB 2019
----------------------------------	---------	--

Source: Delaware ESC Handbook & Filtrex TM International	Symbol:	Detail No. DE-ESC-3.4.5 Sheet 2 of 3 Effective FEB 2019
---	---------	--

Source: Delaware ESC Handbook	Symbol:	Detail No. DE-ESC-3.4.3 Sheet 2 of 4 Effective FEB 2019
--------------------------------------	---------	--

Source: Delaware ESC Handbook & Filtrexx™ International	Symbol:	Detail No. DE-ESC-3.4.5 Sheet 3 of 3 Effective FEB 2019
---	---------	---

Source: Delaware ESC Handbook	Symbol:	Detail No. DE-ESC-3.4.3 Sheet 3 of 4 Effective FEB 2019
--------------------------------------	---------	--

Source: Adapted from MD Sids. & Specs. for ESC	Symbol: 	Detail No. DE-ESC-3.2.1.1 Sheet 1 of 1 Effective FEB 2019
--	--	--

Source: Delaware ESC Handbook	Symbol:	Detail No. DE-ESC-3.4.3 Sheet 4 of 4 Effective FEB 2019
----------------------------------	---------	---

C:\Users\j\Documents\2017 Engineering\CA\175013.4\Construction Plans\175013.4\175013.4.dwg 11/2/2020 2:30 PM

Standard Detail & Specifications

Turbidity Curtain

Typical Section - Type 1

DATA

Curtain type (1, 2, or 3)
Layout (Std. or Alt.)

Source:	Symbol:	Detail No.
Adapt. from Amer. Boom and Barrier Corp.	TC-(1/2/3) (Std/Alt)	DE-ESC-3.5.3 Sheet 1 of 8 Effective FEB 2019

Standard Detail & Specifications

Turbidity Curtain

Typical Section - Type 2

DATA

Curtain type (1, 2, or 3)
Layout (Std. or Alt.)

Source:	Symbol:	Detail No.
Adapt. from Amer. Boom and Barrier Corp.	TC-(1/2/3) (Std/Alt)	DE-ESC-3.5.3 Sheet 2 of 8 Effective FEB 2019

Standard Detail & Specifications

Turbidity Curtain

Typical Section - Type 3

DATA

Curtain type (1, 2, or 3)
Layout (Std. or Alt.)

Source:	Symbol:	Detail No.
Adapt. from Amer. Boom and Barrier Corp.	TC-(1/2/3) (Std/Alt)	DE-ESC-3.5.3 Sheet 3 of 8 Effective FEB 2019

Standard Detail & Specifications

Turbidity Curtain

NOTE: The standard layout shown is intended for use in streams, ponds and other non-tidal waters

Plan - Std. Layout

Source:	Symbol:	Detail No.
Adapt. from Amer. Boom and Barrier Corp.	TC-(1/2/3) (Std/Alt)	DE-ESC-3.5.3 Sheet 4 of 8 Effective FEB 2019

Standard Detail & Specifications

Turbidity Curtain

NOTE: The alternative layout shown is intended for tidal waters and/or heavy wind and wave action

Plan - Alt. Layout

Additional Requirements for Navigable Waters

Source:	Symbol:	Detail No.
Adapt. from Amer. Boom and Barrier Corp.	TC-(1/2/3) (Std/Alt)	DE-ESC-3.5.3 Sheet 5 of 8 Effective FEB 2019

Standard Detail & Specifications

Turbidity Curtain

Construction Notes:

- Materials**
 - Barriers should be a bright color (yellow or "international" orange are recommended) that will attract the attention of nearby boaters.
 - The curtain fabric shall meet manufacturer's recommendations for the application.
 - Seams in the fabric shall be either vulcanized welded or sewn and shall develop the full strength of the fabric.
 - Floatation devices shall be flexible, buoyant units contained in an individual floatation sleeve or collar attached to the curtain. Buoyancy provided by the floatation units shall be sufficient to support the weight of the curtain and maintain a freeboard of at least 3 inches above the water surface level.
 - Load lines must be fabricated into the bottom of all floating turbidity curtains. Type II and Type III must have load lines also fabricated into the top of the fabric. The top load line shall consist of woven webbing or vinyl-sheathed steel cable and shall have a break strength in excess of 10,000 pounds. The supplemental (bottom) load line shall consist of a chain incorporated into the bottom hem of the curtain of sufficient weight to serve as ballast to hold the curtain in a vertical position. Additional anchorage shall be provided as necessary. The load lines shall have suitable connecting devices which develop the full breaking strength for connection to load lines in adjacent sections as shown in the detail.
 - External anchors may consist of wooden or metal stakes (2- x 4-inch or 2-1/2-inch minimum diameter wood or 1.33 lbs/linear foot steel) when Type I installation is used; when Type II or Type III installations are used, bottom anchors should be used.
 - Bottom anchors must be sufficient to hold the curtain in the same position relative to the bottom of the watercourse without interfering with the action of the curtain. The anchor may dig into the bottom (grappling hook, plow or fluke-type) or may be weighted (mushroom type) and should be attached to a floating anchor buoy via an anchor line. The anchor line should then run from the buoy to the to the load line of the curtain. When used with Type III installations, these lines must contain enough slack to allow the buoy and curtain to float freely with tidal changes without pulling the buoy or curtain down and must be checked regularly to make sure they do not become entangled with debris. As previously noted, anchor spacing will vary with current velocity and potential wind and wave action; manufacturer's recommendations should be followed. See detail for orientation of external anchors and anchor buoys for tidal installations.
- Installation**
 - In the calm water of lakes or ponds (Type I installation) it is usually sufficient to set the curtain end stakes or anchor points (using anchor buoys if bottom anchors are employed), then tow the curtain in the furling condition out and attach it to the stakes or anchor points. Following this, any additional stakes or buoyed anchors required to maintain the desired location of the curtain may be set and these anchor points made fast to the curtain. Only then shall the furling lines be cut to allow the curtain skirt to drop.
 - In rivers or in other moving waters (Type II and Type III installations) it is important to set all curtain anchor points. Care must be taken to ensure that anchor points are of sufficient holding power to retain the curtain under the existing current conditions, prior to putting the furling curtain into the water. Anchor buoys should be employed on all anchors to prevent the current from submerging the floatation at the anchor points. If the curtain is being installed into tidal areas which would be subject to currents in both directions, anchors should be provided on both sides of the curtain. This will minimize curtain movement and prevent the curtain from overrunning the anchors during tide reversals. After the anchors have been secured, the furling curtain should be secured to the upstream anchor point and then sequentially attached to each next downstream anchor point until the entire curtain is in position. Before unfurling, the "lay" of the curtain should be assessed and any necessary adjustments made to the anchors. Once the location has been deemed adequate, the furling lines may be cut to allow the skirt to drop.
 - Anchor lines should be attached to the floatation device, not to the bottom of the curtain. The anchoring line attached to the floatation device on the downstream side will provide support for the curtain. Attaching the anchors to the bottom of the curtain could cause premature failure of the curtain due to the stresses imparted on the middle section of the curtain.
 - Turbidity curtain shall not be installed across channel flows unless there is a danger of causing sediment deposition to occur in the middle of a watercourse, thereby blocking access or creating a sand bar. In such situations, the curtain may be installed so as to form a long-sided, sharp "V" to deflect clean water around a work site, confining most of the silt-laden water to the work area inside the "V" and directing it to the shoreline. In no case shall the curtain be installed perpendicular to the channel flow.

Source:	Symbol:	Detail No.
Adapt. from Amer. Boom and Barrier Corp.	TC-(1/2/3) (Std/Alt)	DE-ESC-3.5.3 Sheet 6 of 8 Effective FEB 2019

Standard Detail & Specifications

Turbidity Curtain

Construction Notes (cont.)

- Installation**
 - In the calm water of lakes or ponds (Type I installation) it is usually sufficient to set the curtain end stakes or anchor points (using anchor buoys if bottom anchors are employed), then tow the curtain in the furling condition out and attach it to the stakes or anchor points. Following this, any additional stakes or buoyed anchors required to maintain the desired location of the curtain may be set and these anchor points made fast to the curtain. Only then shall the furling lines be cut to allow the curtain skirt to drop.
 - In rivers or in other moving waters (Type II and Type III installations) it is important to set all curtain anchor points. Care must be taken to ensure that anchor points are of sufficient holding power to retain the curtain under the existing current conditions, prior to putting the furling curtain into the water. Anchor buoys should be employed on all anchors to prevent the current from submerging the floatation at the anchor points. If the curtain is being installed into tidal areas which would be subject to currents in both directions, anchors should be provided on both sides of the curtain. This will minimize curtain movement and prevent the curtain from overrunning the anchors during tide reversals. After the anchors have been secured, the furling curtain should be secured to the upstream anchor point and then sequentially attached to each next downstream anchor point until the entire curtain is in position. Before unfurling, the "lay" of the curtain should be assessed and any necessary adjustments made to the anchors. Once the location has been deemed adequate, the furling lines may be cut to allow the skirt to drop.
 - Anchor lines should be attached to the floatation device, not to the bottom of the curtain. The anchoring line attached to the floatation device on the downstream side will provide support for the curtain. Attaching the anchors to the bottom of the curtain could cause premature failure of the curtain due to the stresses imparted on the middle section of the curtain.
 - Turbidity curtain shall not be installed across channel flows unless there is a danger of causing sediment deposition to occur in the middle of a watercourse, thereby blocking access or creating a sand bar. In such situations, the curtain may be installed so as to form a long-sided, sharp "V" to deflect clean water around a work site, confining most of the silt-laden water to the work area inside the "V" and directing it to the shoreline. In no case shall the curtain be installed perpendicular to the channel flow.

Source:	Symbol:	Detail No.
Adapt. from Amer. Boom and Barrier Corp.	TC-(1/2/3) (Std/Alt)	DE-ESC-3.5.3 Sheet 7 of 8 Effective FEB 2019

Standard Detail & Specifications

Turbidity Curtain

Construction Notes (cont.)

- Maintenance**
 - The individual(s) identified on the plan as responsible for maintenance of the curtain shall do so for the duration of the project in order to ensure the continuous protection of the watercourse.
 - Should repairs to the geotextile fabric become necessary, repair kits are generally available from the manufacturer. The manufacturer's instructions must be followed to ensure the adequacy of the repair.
 - When the curtain is no longer required as determined by the inspector, the curtain and related components shall be removed in such a manner as to minimize turbidity. Remaining sediment shall be sufficiently settled before removing the curtain. Sediment may be removed and the original depth (or plan elevation) restored. Any spoils must be taken to an approved upland disposal area and stabilized in accordance with the approved plan.
- Removal**
 - Care shall be taken to protect the skirt from damage as the turbidity curtain is dragged from the watercourse.
 - The site selected to bring the curtain ashore should be free of sharp rocks, broken cement, debris, etc. so as to minimize damage when hauling the curtain over the area.
 - If the curtain has a deep skirt, it can be further protected by running a small boat along its length with a crew installing furling lines before attempting to remove the curtain from the water.

Source:	Symbol:	Detail No.
Adapt. from Amer. Boom and Barrier Corp.	TC-(1/2/3) (Std/Alt)	DE-ESC-3.5.3 Sheet 8 of 8 Effective FEB 2019

This drawing is the property of Century Engineering, Inc. and is prepared for the exclusive use of its clients at the location indicated. No other use is authorized or intended.

CENTURY
ENGINEERING, INC.

ADDRESS: 550 BAY ROAD
DOVER, DE 19901
P: (302) 734-9188 F: (302) 734-4589
WEBSITE: www.centuryeng.com
EMAIL: ce@centuryeng.com

REVISIONS

ADDENDUM

DESCRIPTION DATE

CONSTRUCTION PLANS
FOR
DELAWARE DIVISION OF FISH & WILDLIFE
GARRISON'S LAKE BOAT RAMP RECONSTRUCTION
LITTLE CREEK HUNDRED, KENT COUNTY, DELAWARE

SHEET TITLE
**EROSION & SEDIMENT
CONTROL DETAILS**

DIV. OF FISH AND WILDLIFE
BID SET
OCTOBER, 2020

DRAWN CHK'D/DISIGNER

ECM AES
SCALE SHEET NO.

AS NOTED
PROJECT NO.
17501343

C110